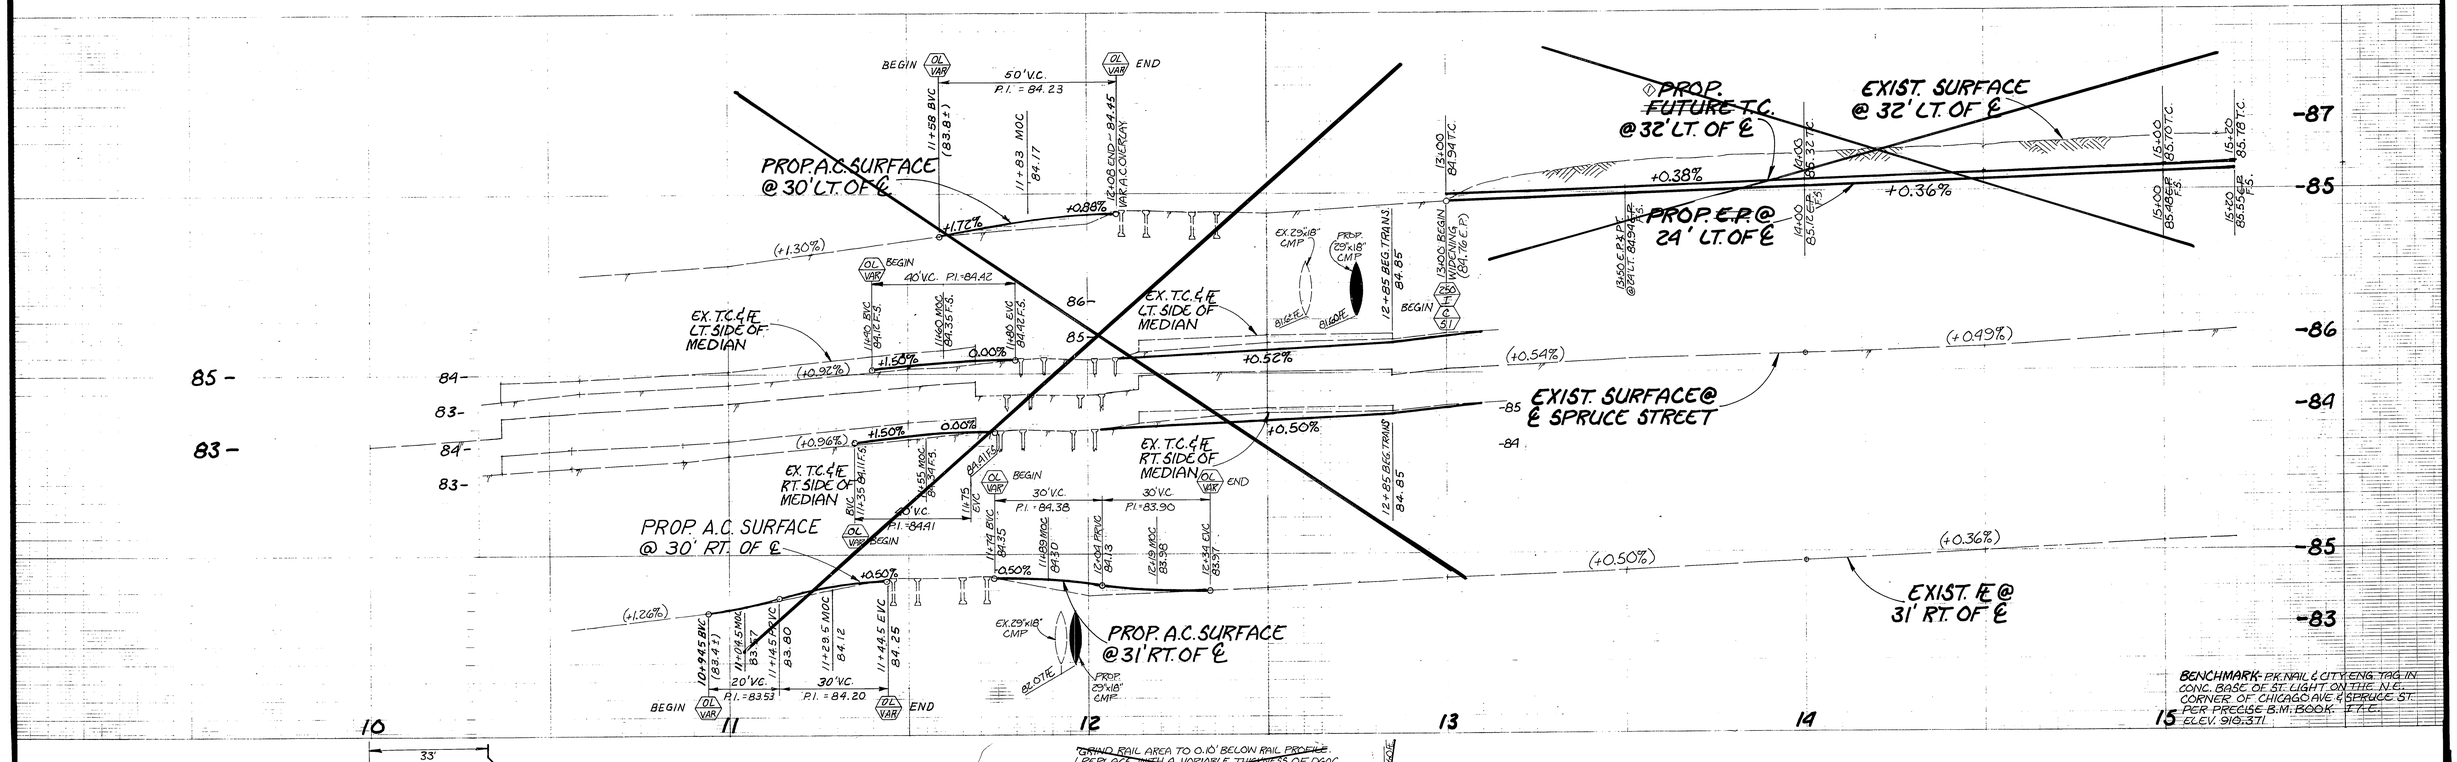

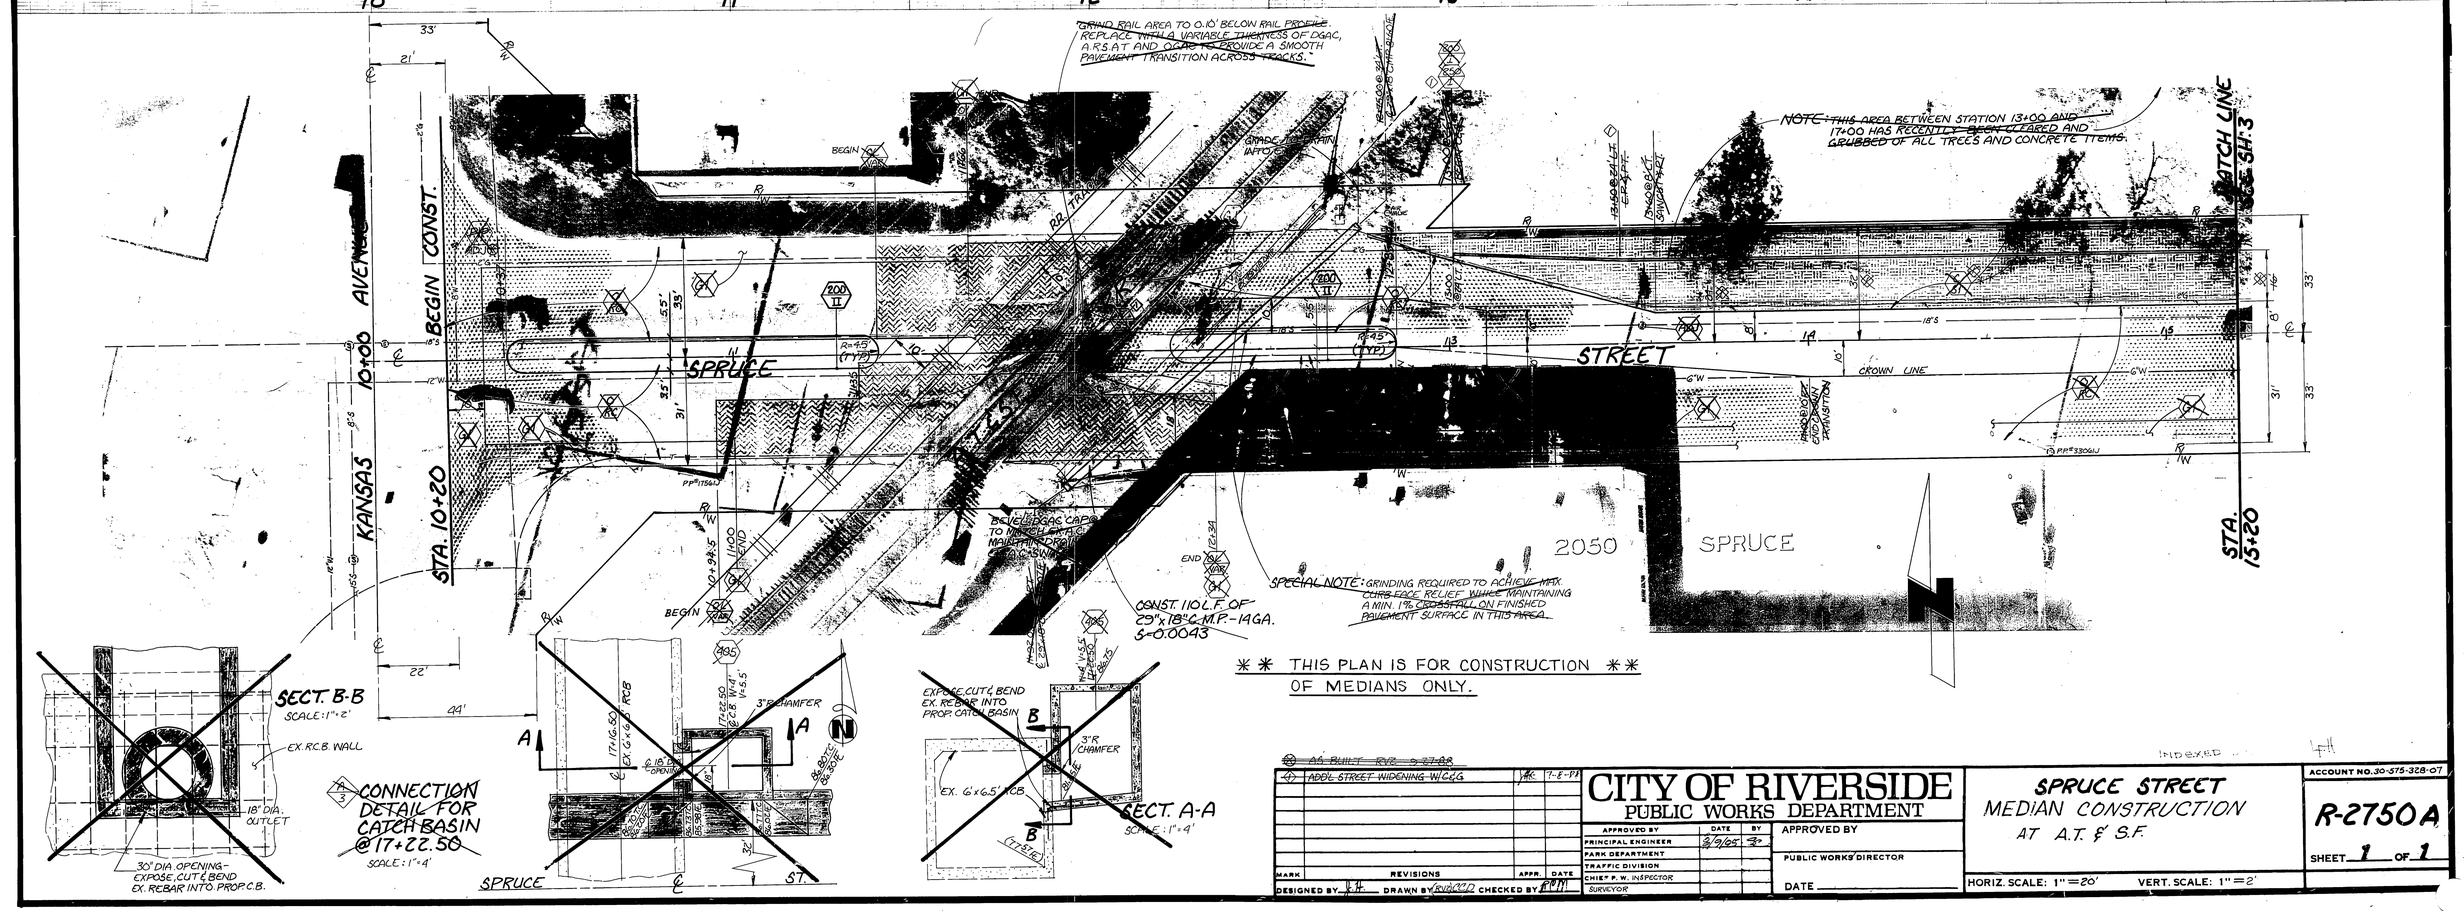

MARK	REVISIONS	APPR.	DATE
4	ADDL STREET WIDENING W/ C&G	JAK	7-8-97
3	~~AS BUILT REV. 5-27-88~~		

DESIGNED BY K.H. DRAWN BY RW/JCC CHECKED BY RPM

CITY OF RIVERSIDE
PUBLIC WORKS DEPARTMENT

APPROVED BY	DATE	BY
PRINCIPAL ENGINEER		
PARK DEPARTMENT	3/9/05	
TRAFFIC DIVISION		
CHIEF P.W. INSPECTOR		
SURVEYOR		

APPROVED BY

PUBLIC WORKS DIRECTOR

DATE

INDEXED

SPRUCE STREET MEDIAN CONSTRUCTION AT A.T. & S.F.

HORIZ. SCALE: 1" = 20' VERT. SCALE: 1" = 2'

ACCOUNT NO. 30-575-328-07

R-2750A

SHEET 1 OF 1