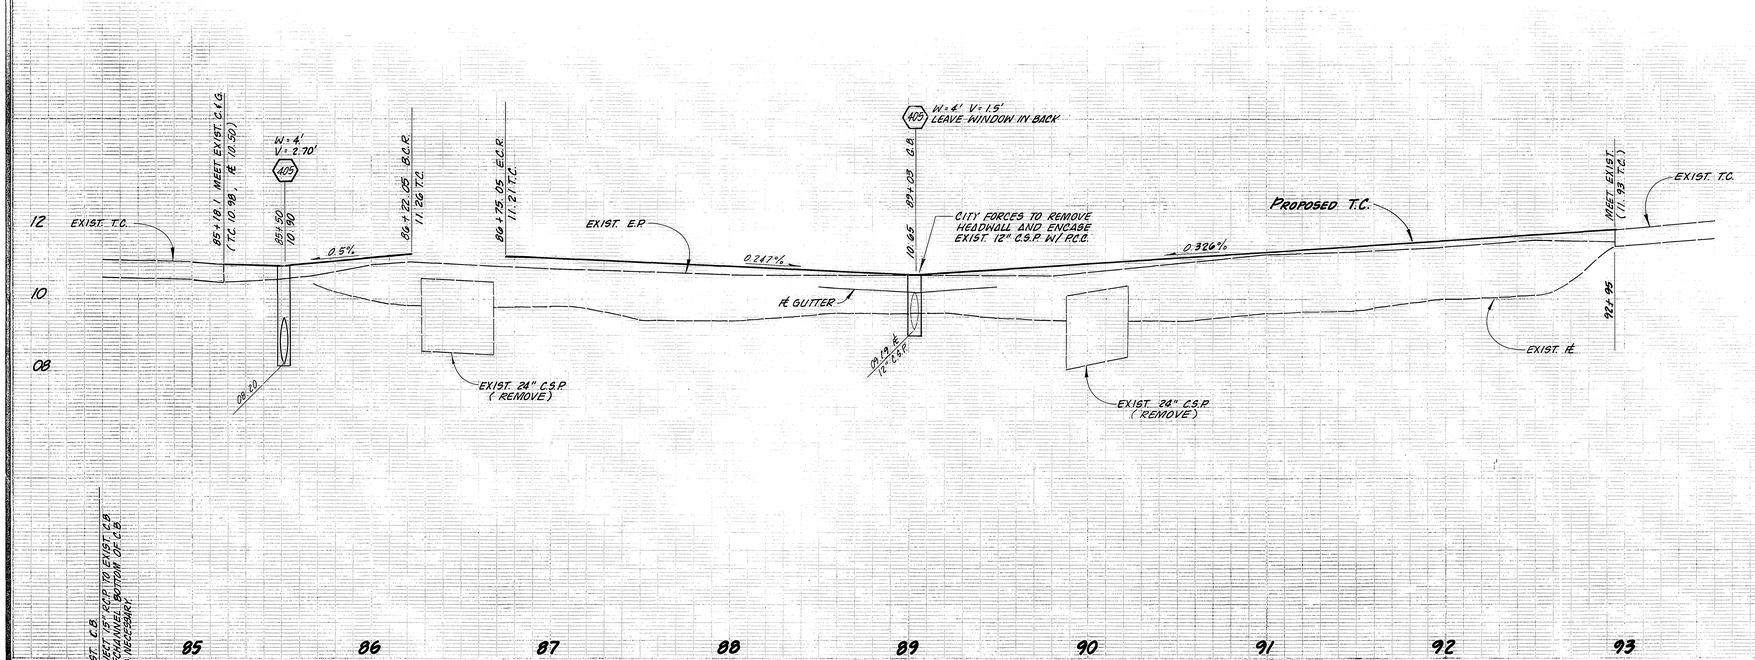

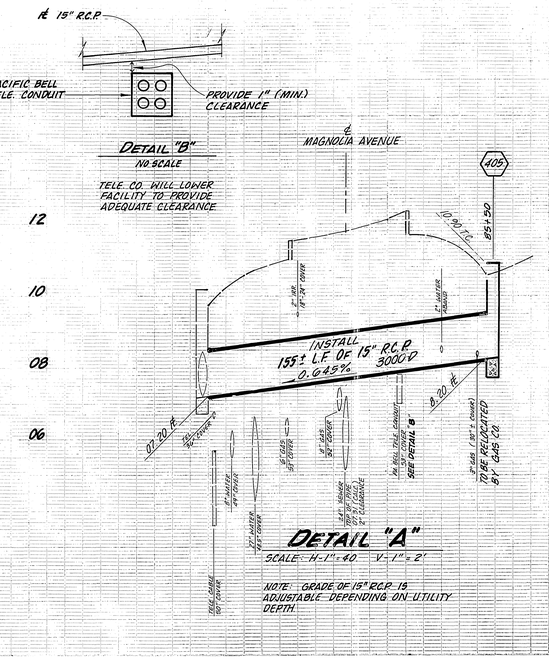

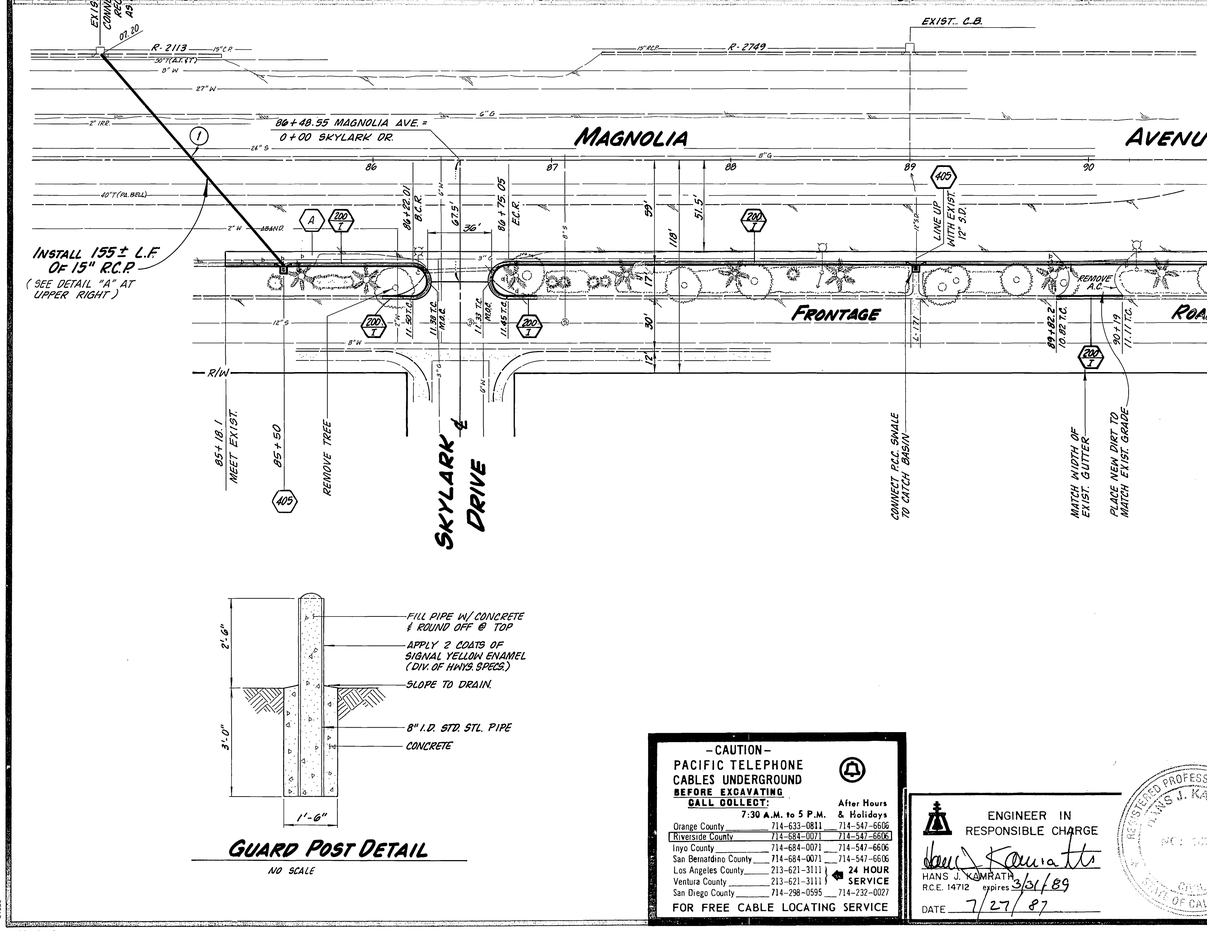

GUARD POST DETAIL

NO SCALE

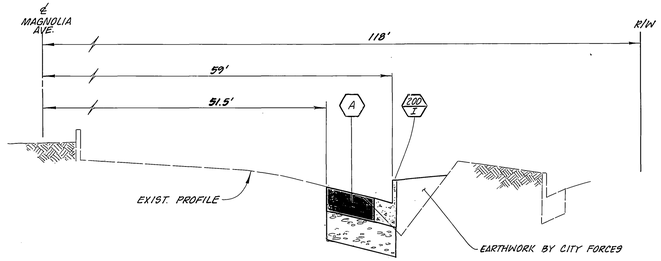

TYPICAL SECTION

NO SCALE

PARK & REC. NOTE: PARK & REC. DEPT. & PUBLIC WORKS DEPT. PERMITS ARE REQUIRED PRIOR TO COMMENCEMENT OF TREE RELOCATION &/OR REMOVAL WORK. FOR ALL TREES WITHIN THE ULTIMATE PAVEMENT AREA, BACKFILL OF ALL HOLES IS TO BE INSPECTED BY THE CITY FOR PROPER COMP.

GENERAL NOTES

1. CONST. SHALL BE IN ACCORDANCE WITH THE CITY OF RIVERSIDE STD. DRAWINGS AND STD. SPECS. FOR PUBLIC WORK'S CONSTRUCTION, 1985 EDITION & 1986, 1987 SUPPL'TS.
2. CITY'S OWN FORCES TO DO BACKFILL OF DITCH, ALL EARTHWORK AND PAVING. CITY'S CONTRACTOR TO DO CURBS & GUTTERS AND DRAINAGE WORK. CITY'S CONTRACTOR TO COORDINATE WITH CITY FORCES.
3. CONTRACTOR TO OBTAIN A PERMIT FROM PARKS DEPARTMENT - (AL CONNER 787-7223 OR 787-5223) AT LEAST 48 HRS. PRIOR TO REMOVAL OF TREE.

CONSTRUCTION NOTES

- (A) CONST. 6" A.C. OVER 8" C.A.B. (BY CITY FORCES).
- (200 I) CONST. CONC. CURB & GUTTER PER STD. DWG. 200, TYPE I - 6" C.F.
- (405) CONST. CATCH BASIN PER STD. DWG. 405
- (1) CONTRACTOR TO POTHOLE 8" GAS LINE BEFORE CUT SHEETS WILL BE ISSUED.
- (8) INSTALL STL. GUARD POST. (SEE SPECS FOR DETAIL)

-CAUTION-
PACIFIC TELEPHONE CABLES UNDERGROUND
BEFORE EXCAVATING CALL COLLECT:
7:30 A.M. to 5 P.M. / After Hours & Holidays

Orange County	714-633-0811	714-547-6606
Riverside County	714-684-0071	714-547-6606
Inyo County	714-684-0071	714-547-6606
San Bernardino County	714-684-0071	714-547-6606
Los Angeles County	213-621-3111	24 HOUR SERVICE
Ventura County	213-621-3111	
San Diego County	714-298-0595	714-232-0027

FOR FREE CABLE LOCATING SERVICE

ENGINEER IN RESPONSIBLE CHARGE
HANS J. KAMRATH
R.C.E. 14712 expires 3/31/89
DATE 7/27/87

REGISTERED PROFESSIONAL ENGINEER HANS J. KAMRATH NO. 14712 CIVIL STATE OF CALIFORNIA

* As built 3.2.88 JE

INDEXED 11-6-87 LH

CITY OF RIVERSIDE
PUBLIC WORKS DEPARTMENT

APPROVED BY	DATE	BY
PRINCIPAL ENGINEER	7-22-87	
PARK DEPARTMENT	7-28-87	
TRAFFIC DIVISION	7-27-87	
INSPECTION	7/27/87	
SURVEY	7/31/87	

APPROVED BY Barry Beck
PUBLIC WORKS DIRECTOR
DATE 7/31/87

MARK	REVISIONS	APPR.	DATE

DESIGNED BY [illegible] DRAWN BY [illegible] CHECKED BY [illegible]

MAGNOLIA AVE. CURB & GUTTER AT SKYLARK DRIVE

E'LY SIDE OF MAGNOLIA AVE. 130' S'LY TO 140' N'LY OF CASTLE OAK DRIVE

HORIZ. SCALE: 1" = 40' VERT. SCALE: 1" = 2'

ACCOUNT NO. 30-575-392-07

R-2797

SHEET ONE OF ONE

7-31 WA

81630

OZALID- NO.1