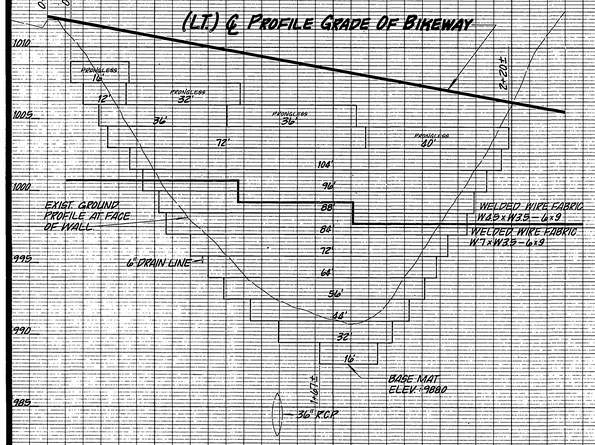

HORZ. 1" = 20'
VERT. 1" = 5'

SECTION AT FACE OF WALL

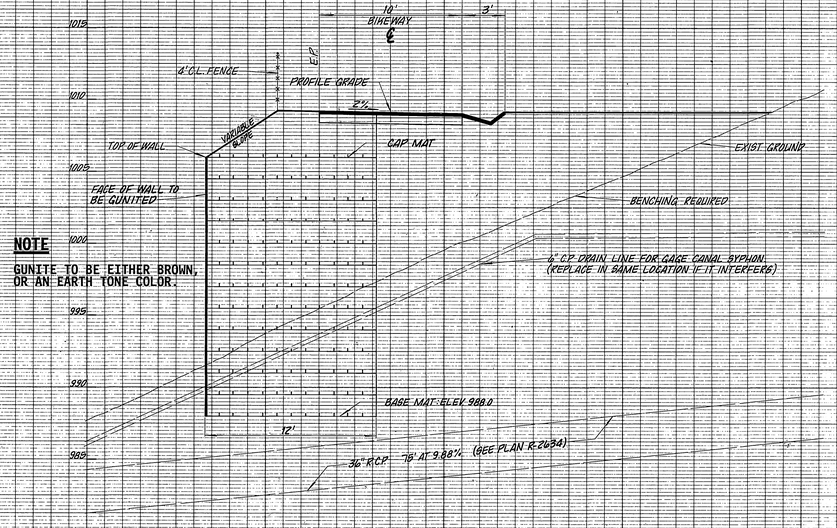

NOTE

GUNITE TO BE EITHER BROWN, OR AN EARTH TONE COLOR.

HORZ. 1" = 5'
VERT. 1" = 5'

CROSS SECTION AT STA. 1+65

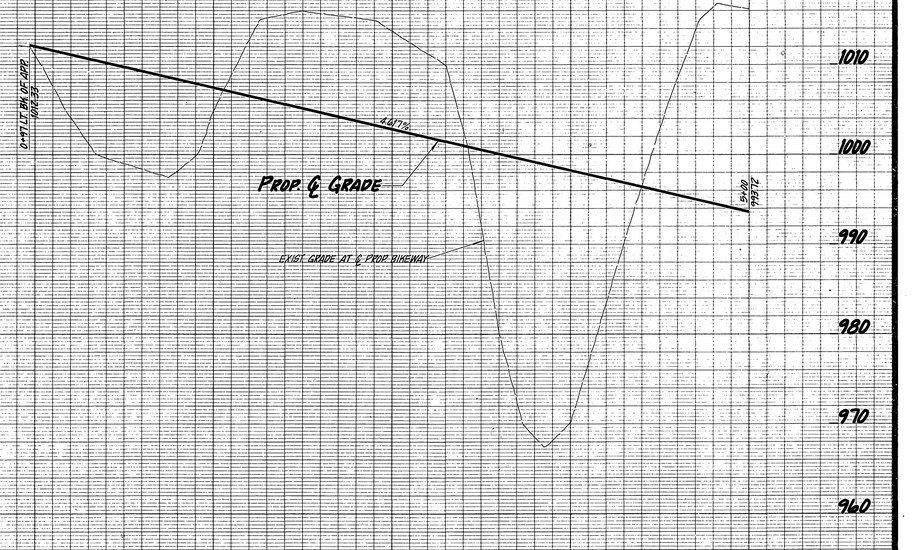

1 2 3 4 5

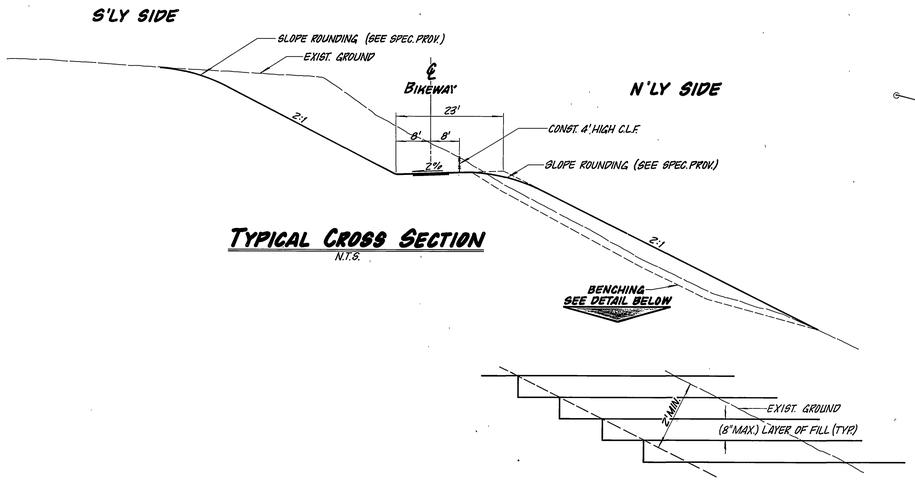

TYPICAL CROSS SECTION

N.T.S.

DETAIL OF BENCHING

(NO SCALE)

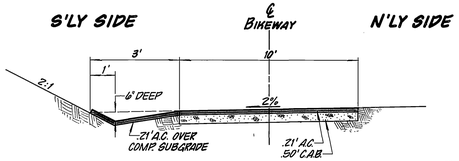

TYPICAL CROSS SECTION OF BIKEWAY

N.T.S.

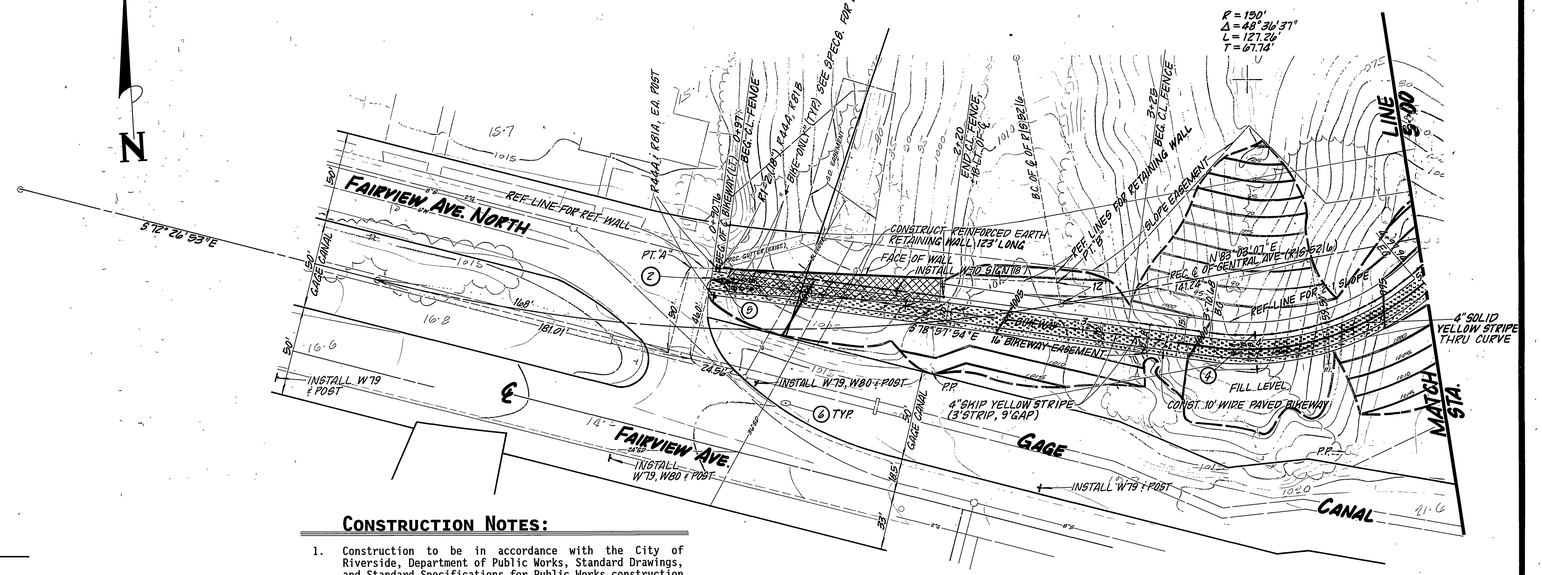

CONSTRUCTION NOTES:

1. Construction to be in accordance with the City of Riverside, Department of Public Works, Standard Drawings, and Standard Specifications for Public Works construction 1988 Edition.
2. Construct Driveway Depression as per Standard Drawing No.303, A=10', B=14'. (Station 0+90.76)
3. Construct Driveway Depression as per Standard Drawing No.303, A=10', B=14'. (Station 16+28.16)
4. Install R44A Signs (12" x 24"), and Posts at ±300' O.C.
5. See Barrier Post Detail in Specifications for Post & Striping Requirements.
6. Replace Steel Post and Cable Barrier after construction is completed. But leave an opening for the Bikeway.

* AS BUILT 6-15-90 B.M.

GAGE CANAL SYSTEM

John M. Hopkins
PRESIDENT - GENERAL MANAGER

1-31-1989
DATE

ENGINEER IN RESPONSIBLE CHARGE

Hans J. Kamrath
HANS J. KAMRATH
R.C.E. 14712 expires 3/31/89

DATE 3/22/1989

REGISTERED PROFESSIONAL ENGINEER HANS J. KAMRATH NO: 14712 CIVIL STATE OF CALIFORNIA

MARK	REVISIONS	APPR	DATE

DESIGNED BY: [illegible] DRAWN BY: [illegible] CHECKED BY:

CITY OF RIVERSIDE
PUBLIC WORKS DEPARTMENT

APPROVED BY		
PRINCIPAL ENGINEER		3-27-89
PARK DEPARTMENT		
TRAFFIC DIVISION		3-27-89
CHIEF P. W. ENGINEER		3-30
Surveyor		2/22/89
CHIEF P.W. INSPECTOR		3/23/89

APPROVED BY
PUBLIC WORKS DIRECTOR
DATE 3/31/89

FAIRVIEW AVENUE BIKEWAY

CHICAGO AVE. TO END OF FAIRVIEW AVE.

HORIZ. SCALE: 1" = 40' VERT. SCALE: 1" = 8'

ACCOUNT NO. 30-575-213-07

R-2852

SHEET 1 OF 2

FILE NO.

INDEXED 8-3-89 LH

ANDULKA PARK (FUTURE)

PROPOSED PARK ENTRANCE ROAD

NOTE:
SEE DIAGRAM AND PROFILE IN SPECIFICATION PACKAGE FOR LAYING OUT THE CURBS FOR PARK ENTRANCE ROAD.

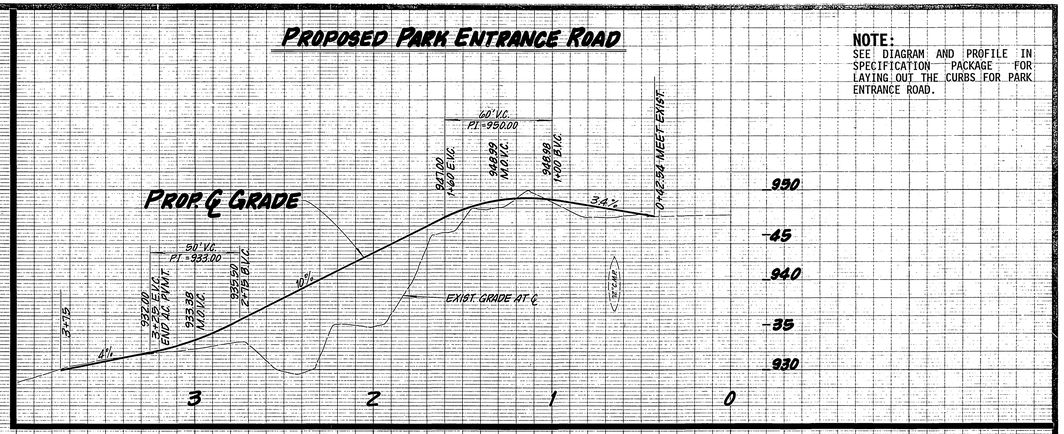

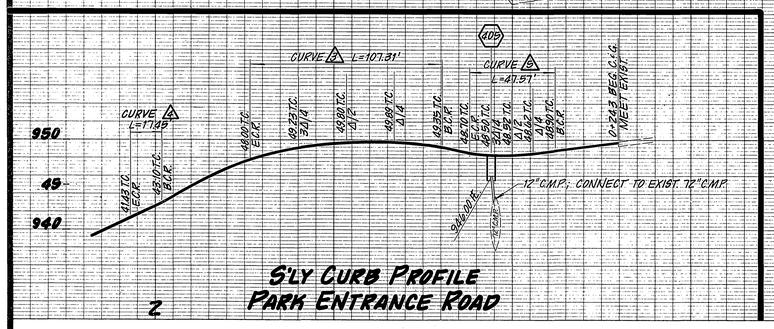

S'LY CURB PROFILE PARK ENTRANCE ROAD

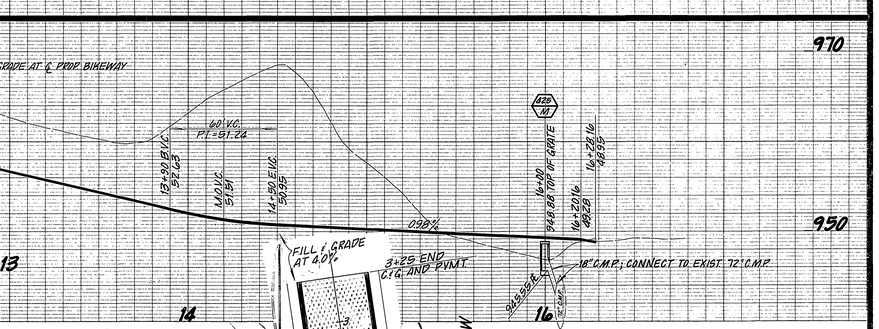

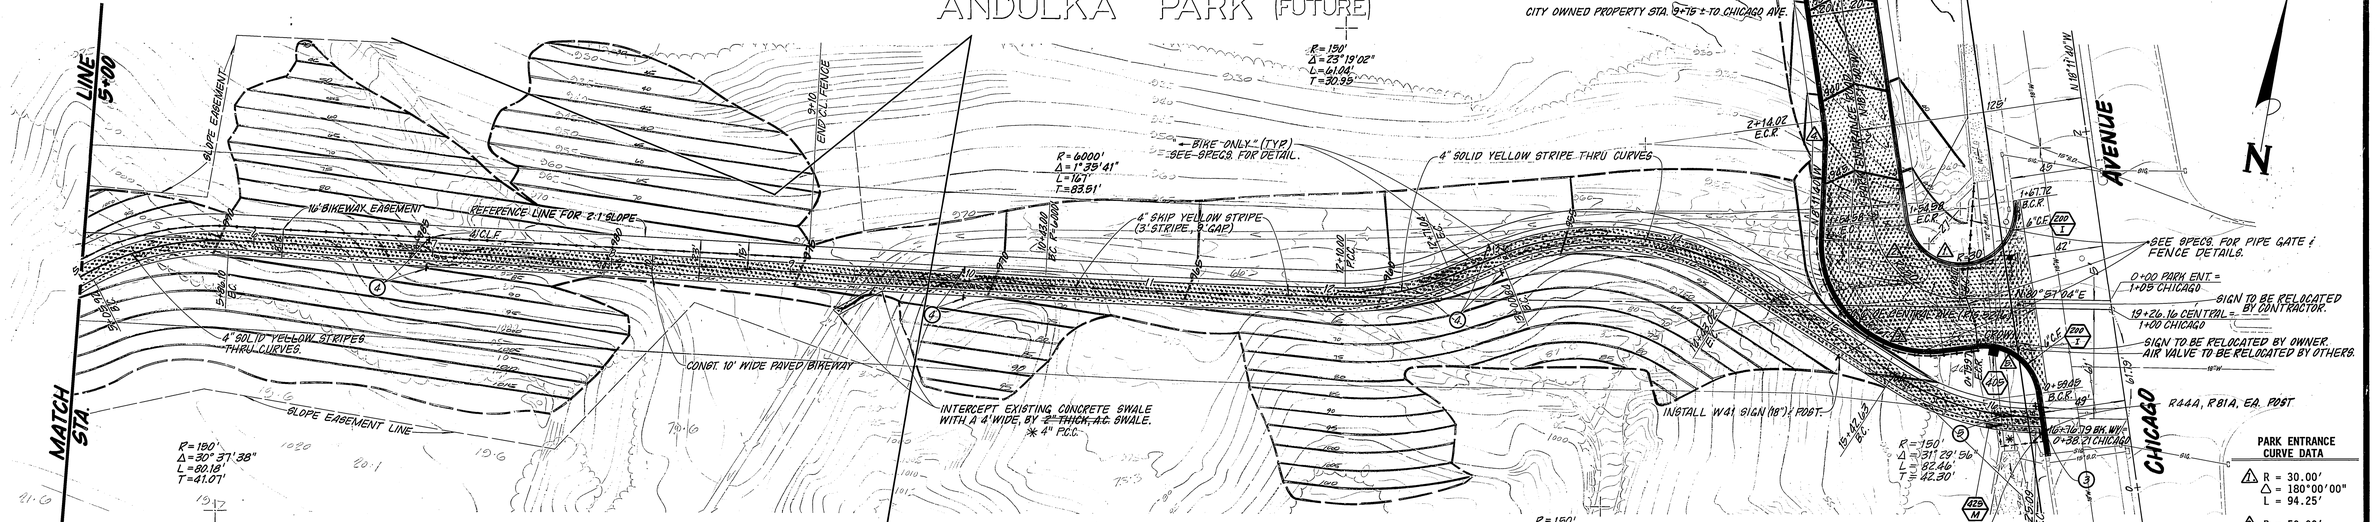

*AS BUILT 6-13-90 B.M.s

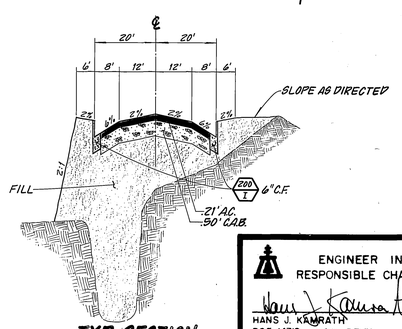

TYP. SECTION PARK ENTRANCE ROAD

N.T.S.

ENGINEER IN RESPONSIBLE CHARGE
HANS J. KAMRATH
R.C.E. 14712 expires 3/31/89
DATE 3/22 1989

REGISTERED PROFESSIONAL ENGINEER HANS J. KAMRATH NO: 14712 CIVIL STATE OF CALIFORNIA

MARK	REVISIONS	APPR	DATE

DESIGNED BY ... DRAWN BY ... CHECKED BY ...

CITY OF RIVERSIDE
PUBLIC WORKS DEPARTMENT

APPROVED BY		
PRINCIPAL ENGINEER		3-27-89
PARK DEPARTMENT		3-17-89
TRAFFIC DIVISION		3-17-89
CHIEF F. W. ENGINEER		3-30
Surveyor		3/30/89
CHIEF P.W. INSPECTOR		3/31/89

APPROVED BY
PUBLIC WORKS DIRECTOR
DATE 3/31/89

FAIRVIEW AVENUE BIKEWAY

CHICAGO AVE. TO END OF FAIRVIEW AVE.

HORIZ. SCALE: 1"=40' VERT. SCALE: 1"=8'

ACCOUNT NO. 30-575-213-07

R-2852

SHEET 2 OF 2

FILE NO.

INDEXED 8-3-89 LH