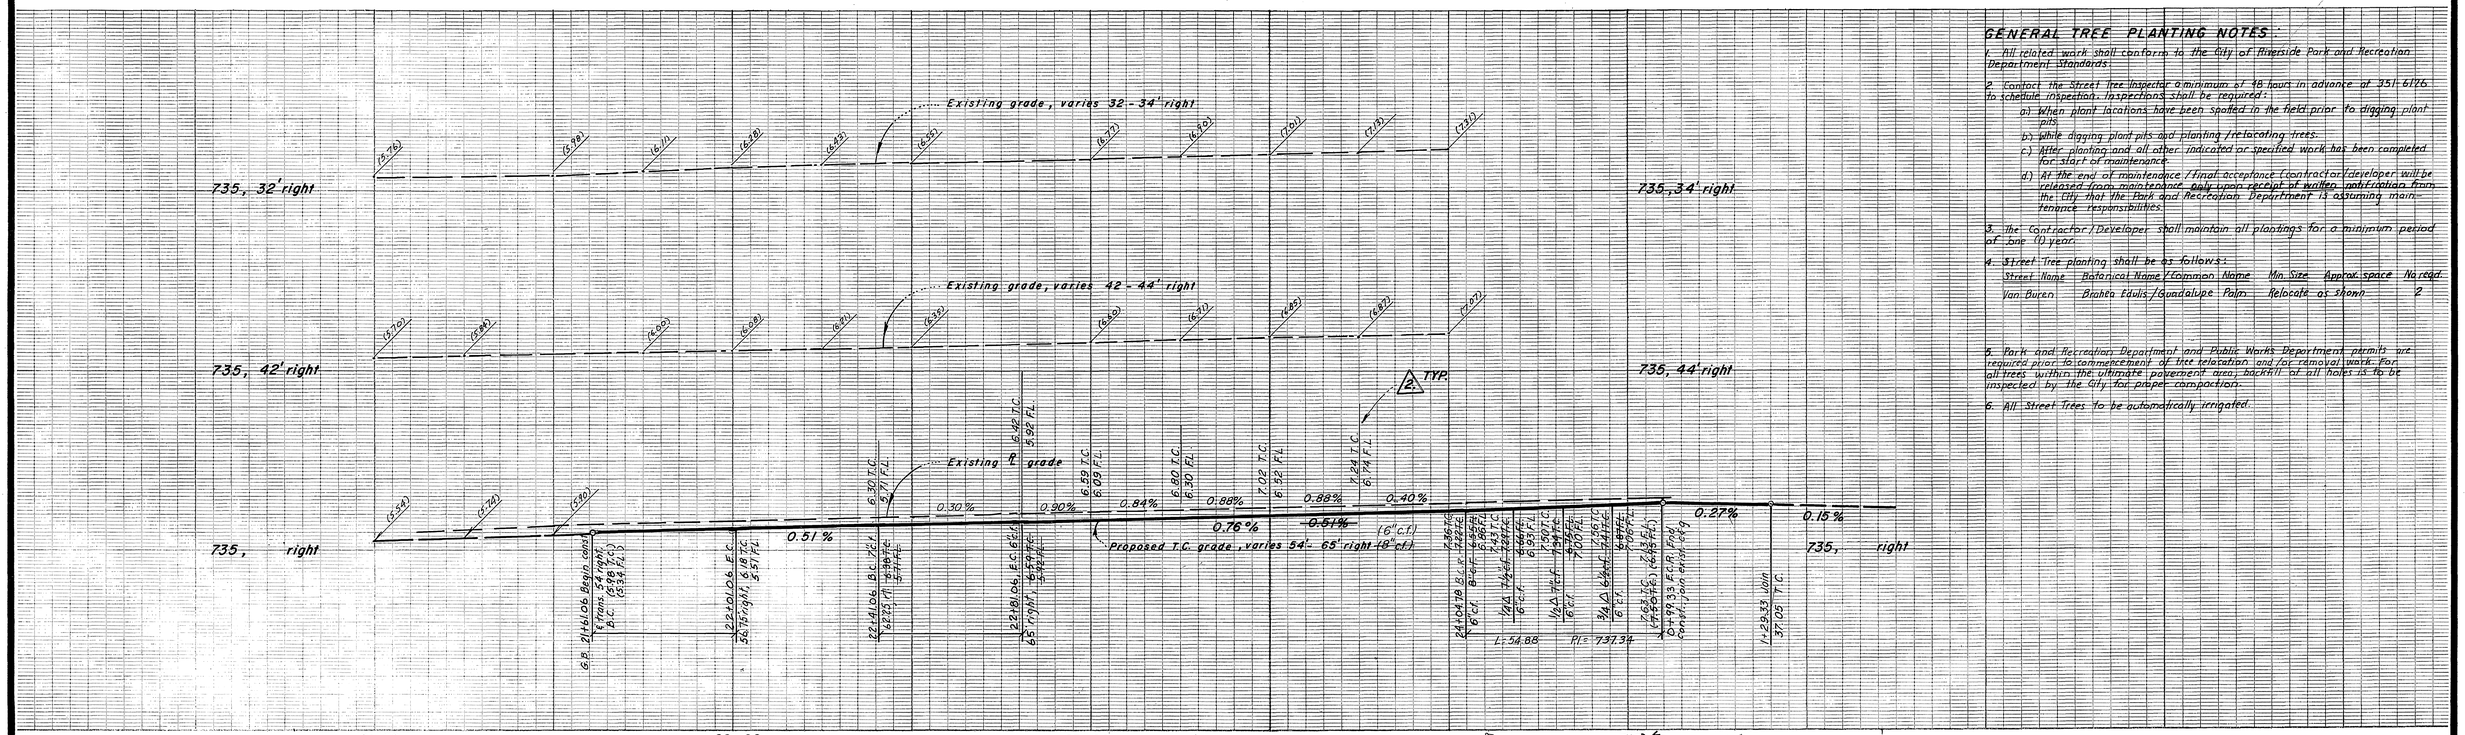

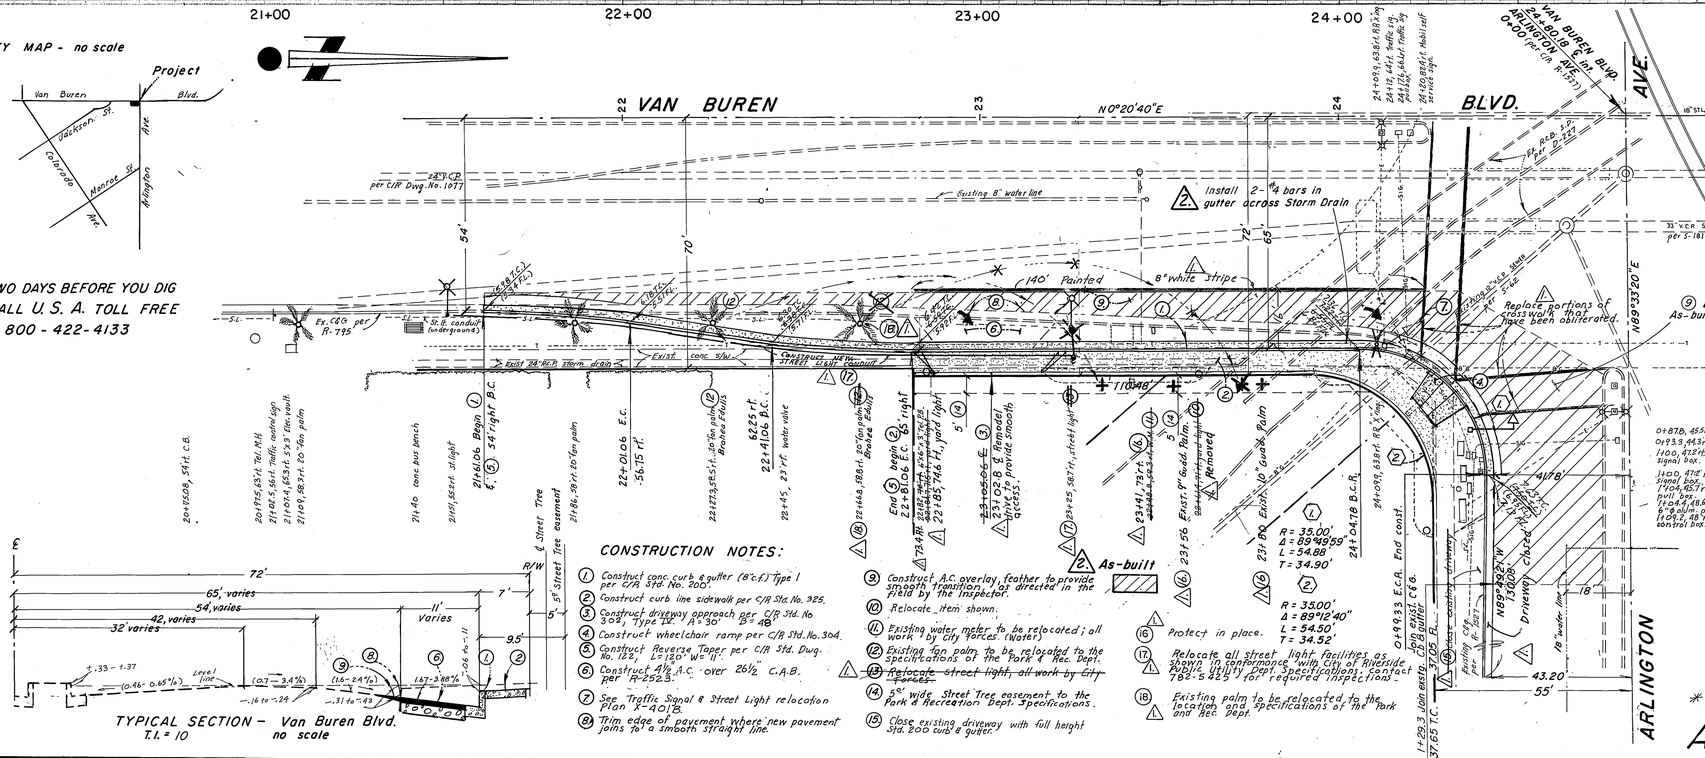
VICINITY MAP - no scale
Project
Van Buren
Blvd.
Jackson St.
Colorado
Ave
Monroe St.
Arlington
Ave.
TWO DAYS BEFORE YOU DIG
CALL U. S. A. TOLL FREE
800 - 422 - 4133
VAN BUREN BLVD.
N0°20'40"E
BLVD.
ARLINGTON AVE.
N89°32'20"E
N89°32'20"W
22
23
24
Existing 8" water line
140' Painted 8" white stripe
Install 2-#4 bars in gutter across Storm Drain
Replace portions of cross walk that have been obliterated.
As-built
Ex. C&G per R-795
St. L. conduit (underground)
Exist 36"-RCP storm drain
Exist conc. s'walk
Existing 8" water line
Ex. 8" V.C.P. sewer per S-181
18" V.C.P. S.
33" V.C.P. Sewer per S-181
