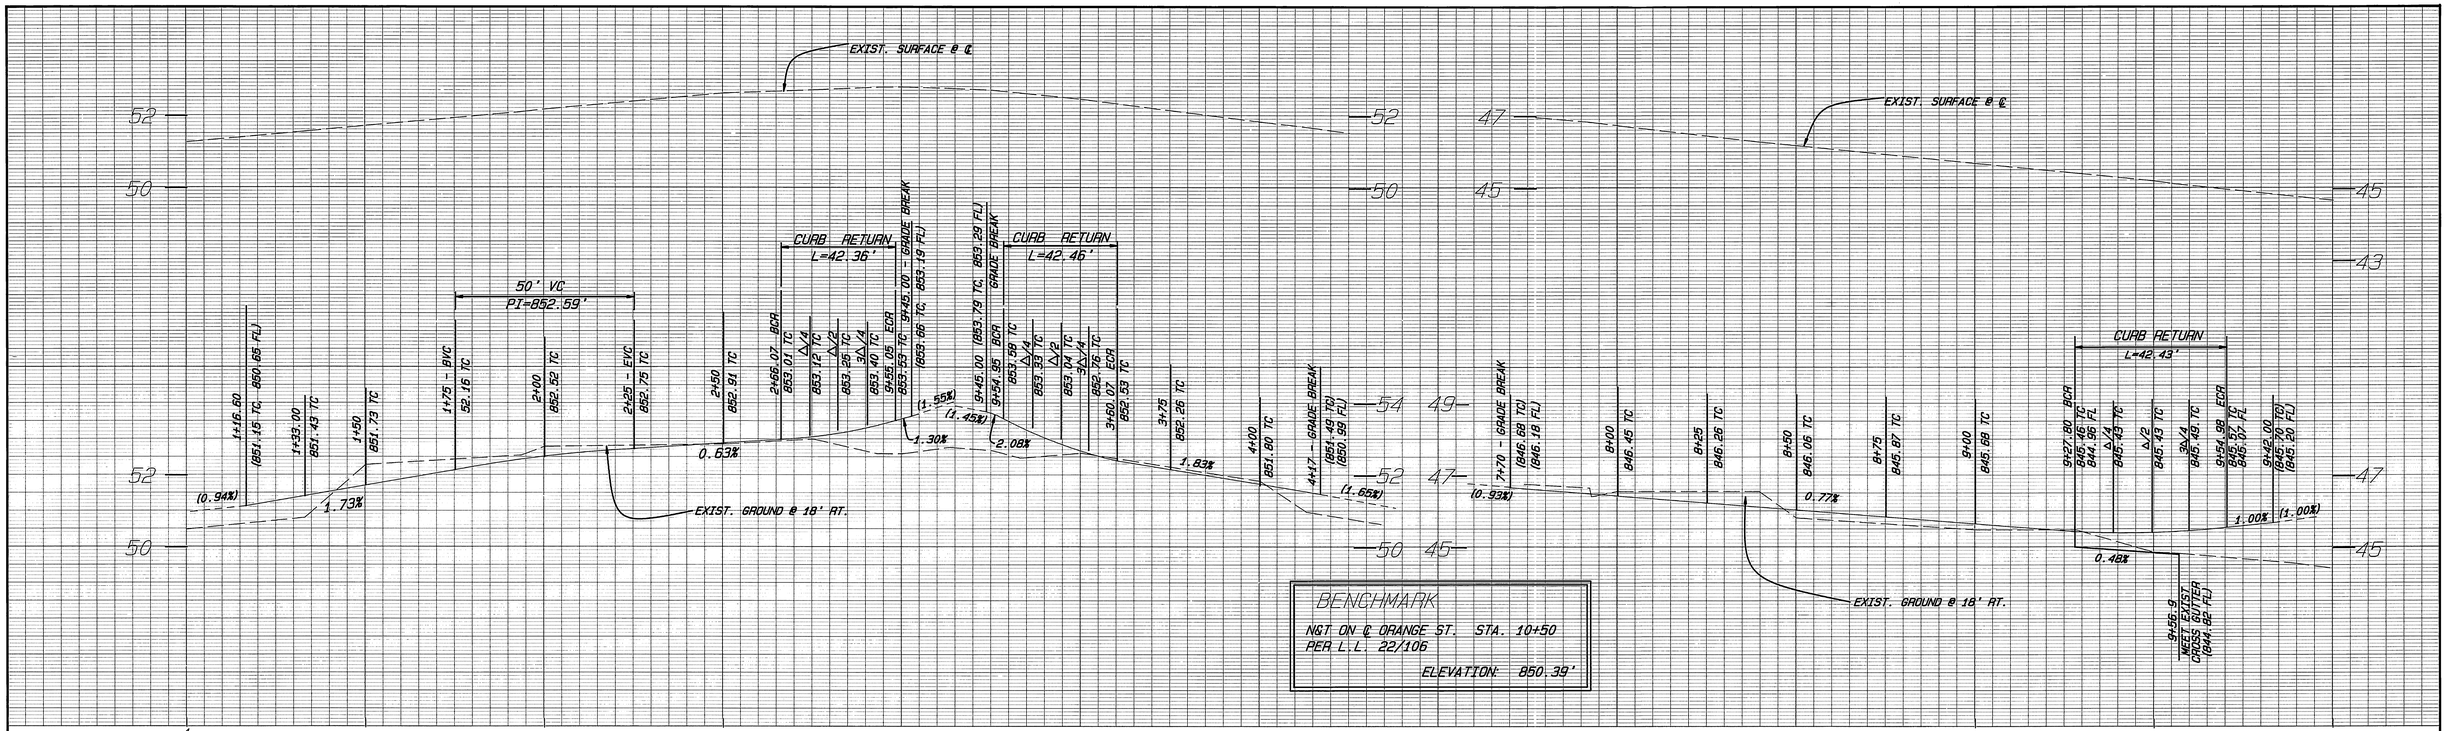

1 CONSTRUCTION NOTES

CONSTRUCT STRUCTURAL SECTION OF 3" DENSE GRADED ASPHALT CONCRETE OVER 6" CRUSHED AGGREGATE BASE.

REMOVE EXIST. ASPHALT AND CONSTRUCT AS ABOVE.

OVERLAY EXIST. ASPHALT TO SPECIFIED GRADE.

PCC CURB, GUTTER, AND DRIVEWAY APPROACH.

2 CONSTRUCTION NOTES 3

NUMBERS ABOVE 100 IN A HEXAGON ON THE PLAN REFER TO THE RESPECTIVE STANDARD DRAWING AND SHALL BE CONSTRUCTED ACCORDINGLY. ANY NUMBER SHOWN BELOW THE NUMBER INDICATES THE SPECIFIC ALTERNATE TO BE CONSTRUCTED.

(1002) PLANT STREET TREES TO THE SPECIFICATIONS OF THE CITY OF RIVERSIDE PARK AND RECREATION DEPARTMENT.

(T / 111) TRANSPLANT TREE, CLASS AS NOTED IN LOWER HALF.

(302 / M) CURB DEPRESSION ONLY, NO CONC. APPROACH.

(304 / M) CURB DEPRESSION ONLY @ MOC.

4 GENERAL NOTES 8

1. ALL CONSTRUCTION SHALL BE IN ACCORDANCE WITH THE CITY OF RIVERSIDE, DEPARTMENT OF PUBLIC WORKS, STANDARD DRAWINGS AND THE STANDARD SPECIFICATIONS FOR PUBLIC WORKS CONSTRUCTION, 1988 EDITION AND THE 1989 SUPPLEMENT.
2. EXISTING UTILITIES SHOWN ON THIS PLAN ARE PLOTTED FROM UTILITY RECORDS. THE CONTRACTOR IS REQUIRED TO TAKE DUE PRECAUTIONARY MEASURES TO LOCATE AND PROTECT ALL UTILITIES WHETHER OR NOT SHOWN ON THIS PLAN.
3. ALL ELEVATIONS SHOWN ON THE PLANS SHALL BE STAKED IN THE FIELD.

9 VICINITY MAP

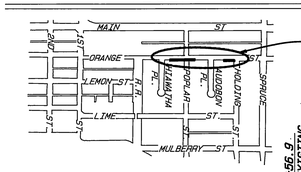

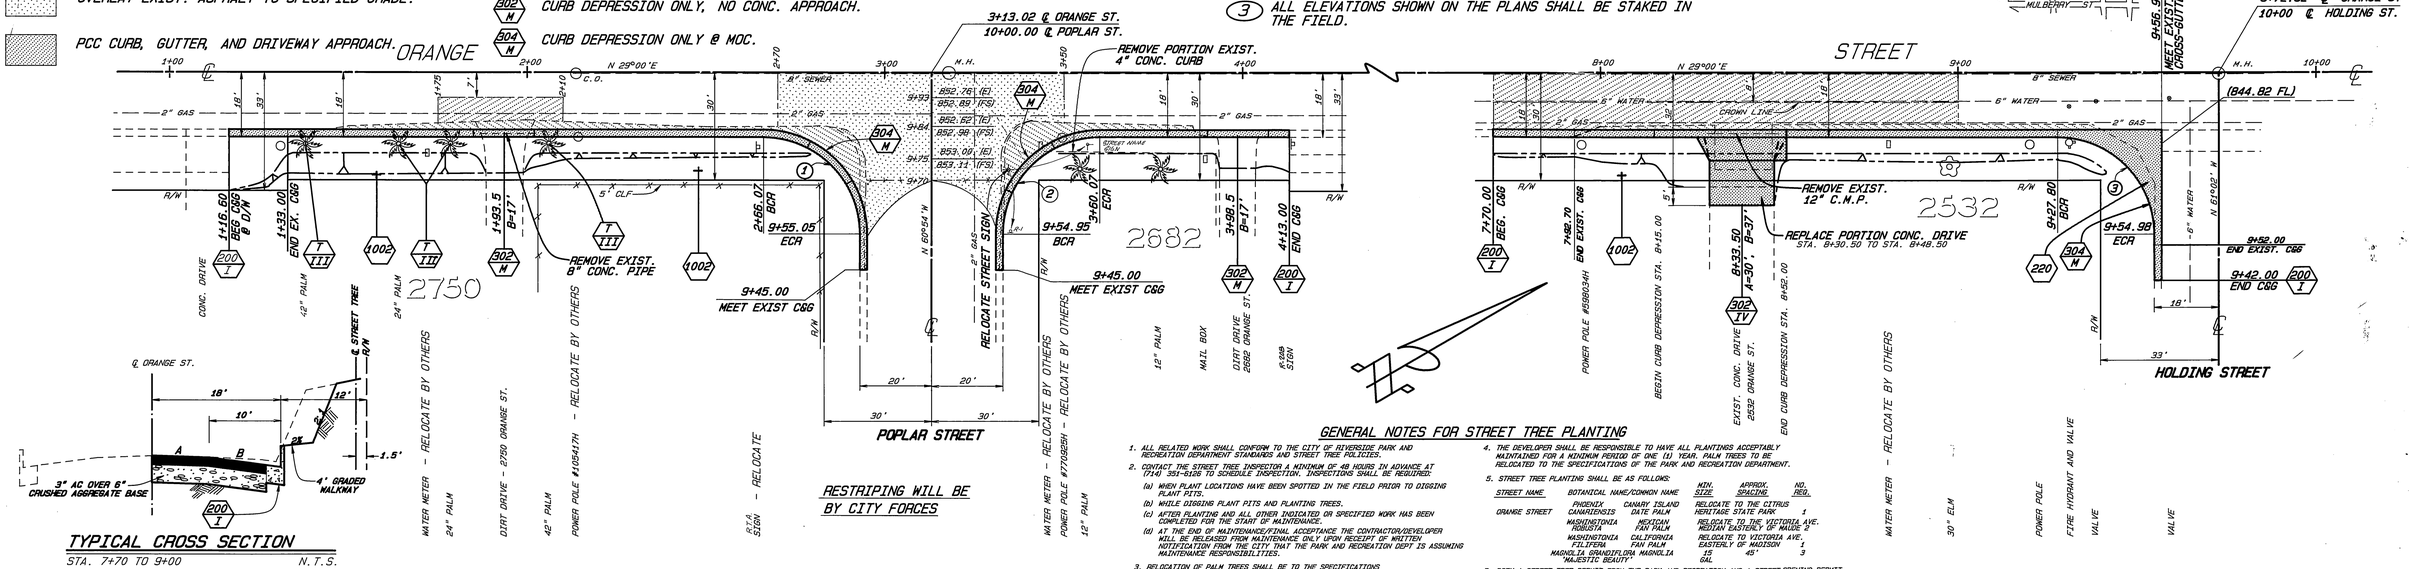

TYPICAL CROSS SECTION
STA. 7+70 TO 9+00 N.T.S.

STA.	CROSS SLOPES A	B
7+70	2.88%	6.00%
B+00	2.38%	6.00%
B+25	1.75%	5.50%
B+50	1.50%	5.00%
B+75	1.32%	5.00%
9+00	1.13%	5.00%

CURVE DATA

○	R	Δ	L	T
1	27'	89°54'00"	42.36'	26.95'
2	27'	90°06'00"	42.46'	27.05'
3	27'	90°02'00"	42.43'	27.02'

GENERAL NOTES FOR STREET TREE PLANTING

1. ALL RELATED WORK SHALL CONFORM TO THE CITY OF RIVERSIDE PARK AND RECREATION DEPARTMENT STANDARDS AND STREET TREE POLICIES.
2. CONTACT THE STREET TREE INSPECTOR A MINIMUM OF 48 HOURS IN ADVANCE AT (714) 351-6128 TO SCHEDULE INSPECTION. INSPECTIONS SHALL BE REQUIRED:
   (a) WHEN PLANT LOCATIONS HAVE BEEN SPOTTED IN THE FIELD PRIOR TO DIGGING PLANT PITS.
   (b) WHILE DIGGING PLANT PITS AND PLANTING TREES.
   (c) AFTER PLANTING AND ALL OTHER INDICATED OR SPECIFIED WORK HAS BEEN COMPLETED FOR THE START OF MAINTENANCE.
   (d) AT THE END OF MAINTENANCE/FINAL ACCEPTANCE THE CONTRACTOR/DEVELOPER WILL BE RELEASED FROM MAINTENANCE ONLY UPON RECEIPT OF WRITTEN NOTIFICATION FROM THE CITY THAT THE PARK AND RECREATION DEPT IS ASSUMING MAINTENANCE RESPONSIBILITIES.
3. RELOCATION OF PALM TREES SHALL BE TO THE SPECIFICATIONS OF THE PARK AND RECREATION DEPARTMENT.
4. THE DEVELOPER SHALL BE RESPONSIBLE TO HAVE ALL PLANTINGS ACCEPTABLY MAINTAINED FOR A MINIMUM PERIOD OF ONE (1) YEAR. PALM TREES TO BE RELOCATED TO THE SPECIFICATIONS OF THE PARK AND RECREATION DEPARTMENT.
5. STREET TREE PLANTING SHALL BE AS FOLLOWS:

STREET NAME	BOTANICAL NAME/COMMON NAME	MIN. SIZE	APPROX. SPACING	NO. REQ.	
ORANGE STREET	PHOENIX CANARIENSIS / CANARY ISLAND DATE PALM		RELOCATE TO THE CITRUS HERITAGE STATE PARK		
	WASHINGTONIA ROBUSTA / MEXICAN FAN PALM		RELOCATE TO THE VICTORIA AVE. MEDIAN EASTERLY OF MAUDE ST		
	WASHINGTONIA FILIFERA / CALIFORNIA FAN PALM		RELOCATE TO VICTORIA AVE. EASTERLY OF MADISON		
	MAGNOLIA GRANDIFLORA 'MAJESTIC BEAUTY' / MAGNOLIA	15 GAL.	45'	3	

6. BOTH A STREET TREE PERMIT FROM THE PARK AND RECREATION AND A STREET OPENING PERMIT FROM PUBLIC WORKS DEPARTMENT SHALL BE REQUIRED PRIOR TO ANY CONSTRUCTION

ENGINEER IN RESPONSIBLE CHARGE
HANS J. KAMRATH
R.C.E. 14712 expires 3/31/93
DATE 7/17/90

REGISTERED PROFESSIONAL ENGINEER HANS J. KAMRATH NO: 14712 CIVIL CALIFORNIA

CITY OF RIVERSIDE
PUBLIC WORKS DEPARTMENT

MARK	REVISIONS	APPR.	DATE

APPROVED BY	DATE	BY
DEPUTY P.W. ENGINEER	7/23/90	RAC
PRINCIPAL ENGINEER	7/26/90	
SURVEYOR	7/19/90	RCH
CHIEF P.W. INSPECTOR	7/20/90	
TRAFFIC DIVISION	7/27/90	
PARK & RECREATION	7-25-90	

APPROVED BY
PUBLIC WORKS DIRECTOR
DATE 8/1/90

DESIGNED BY DPY DRAWN BY DPY, B.M.S CHECKED BY

ORANGE ST. CURB & GUTTER
HIAWATHA ST. TO HOLDING ST.
(HUD FUNDED PROJECT)

HORIZ. SCALE: 1"= 20' VERT. SCALE: 1"= 2'

ACCOUNT NO. 15-550-597-43
R-3115
SHEET 1 OF 1

*AS BUILT 1-17-91 BMS

INDEXED 8-21-90

TELEDYNE POST 123120