RIVERSIDE CALIFORNIA

CITY OF RIVERSIDE — INCORPORATED 1883

PUBLIC WORKS DEPARTMENT

JURUPA AVENUE

WIDENING

FROM VAN BUREN BLVD. TO U.P.R.R.
T.I. = 10.5 (VAN BUREN BLVD. TO ESSEX ST./ADAM ST. EXT.)
T.I. = 9.5 (ESSEX ST. TO GRAND AVE.)

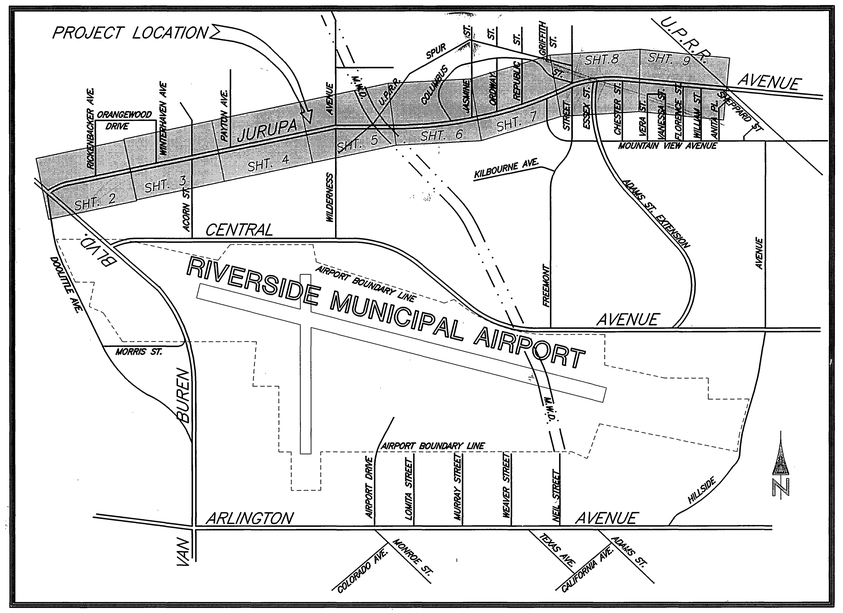

PROJECT LOCATION MAP

0 KM. 0.5 KM. 1 KM. 1.5 KM.
0' 500' 1000' 2000' 3000' 4000' 5000' 6000'

SCALE: 1" = 1,000'

SHEET INDEX

STREET PLANS (R-3291)

SHEET NO.	DESCRIPTION
1	TITLE SHEET
2 TO 9	STREET IMPROVEMENT PLANS
10	INTERSECTION & MISC. DETAILS
11 TO 12	TYPICAL STREET SECTIONS
13	PROFILE INTERSECTING STREETS
14	STORM DRAIN LATERALS

TRAFFIC PLANS

SHEET NO.	DESCRIPTION
1	SIGNAL AT JURUPA AND VAN BUREN (X-485)
1	SIGNAL AT JURUPA AND FREMONT (X-237)
1 TO 4	STRIPING & SIGNING PLANS (XL-349)

GENERAL CONSTRUCTION NOTES:

1. CONSTRUCTION SHALL BE IN ACCORDANCE WITH THE CITY OF RIVERSIDE STANDARD DRAWINGS AND STANDARD SPECIFICATIONS FOR PUBLIC WORKS CONSTRUCTION 1994 EDITION.
2. EXISTING UTILITIES SHOWN ON THE PLAN, ARE PLOTTED FROM UTILITY RECORDS. THE CONTRACTOR IS REQUIRED TO TAKE DUE PRECAUTIONARY MEASURES TO LOCATE AND PROTECT ALL UTILITIES WHETHER OR NOT SHOWN ON THIS PLAN.
3. PRIME CONTRACTORS BIDDING THIS WORK SHALL HAVE A CLASS "A" LICENSE.
4. ALL ELEVATIONS SHOWN ON THE PLANS SHALL BE STAKED IN THE FIELD.
5. CUT AND FILL SLOPES SHALL BE 1.5:1 OR FLATTER.

SPECIFIC CONSTRUCTION NOTES:

- NUMBERS ABOVE 100 IN A HEXAGON ON THE PLAN REFER TO THE RESPECTIVE STANDARD DRAWING AND SHALL BE CONSTRUCTED ACCORDINGLY, UNLESS MODIFICATIONS ARE NOTED ON THE PLAN. ANY NUMBER SHOWN BELOW THE STANDARD DRAWING NUMBER INDICATES THE SPECIFIC ALTERNATE TO BE CONSTRUCTED.
- 412 / M — CONSTRUCT CSP INLET PER STD. DWG. 412 @ STA. 84+04 EXCEPT THE TOP GRATE OF EXISTING CSP INLET SHALL BE REINSTALLED TO FIT THE NEW CSP INLET.
- E — PUD, ELECTRIC DIV. TO RELOCATE.
- W — PUD, WATER DIV. TO RELOCATE/EXTEND.
- G — SOUTHERN CALIF. GAS CO. TO RELOCATE OR ADJUST TO GRADE.
- T — PACIFIC TEL. CO. TO RELOCATE OR ADJUST TO GRADE.

CONSTRUCTION LEGEND:

- C / S1 — CONSTRUCT STRUCTURAL SECTION OF 0.50' AC OVER 1.95' CAB OR 1.33' A.C. OVER COMPACTED NATIVE MATERIAL.
- C / S2 — CONSTRUCT STRUCTURAL SECTION OF 0.50' AC OVER 1.48' CAB OR 1.16' A.C. OVER COMPACTED NATIVE MATERIAL.
- C / S3 — CONSTRUCT STRUCTURAL SECTION OF 0.50' A.C. OVER 1.65' CAB OR 1.18' A.C. OVER COMPACTED NATIVE MATERIAL.
- C / S4 — CONSTRUCT STRUCTURAL SECTION OF 0.35' A.C. OVER 1.45' CAB OR 0.95' A.C. OVER COMPACTED NATIVE MATERIAL.
- C / S5 — CONSTRUCT STRUCTURAL SECTION OF 1.33' A.C. OVER COMPACTED NATIVE MATERIAL.
- R / S1 — REMOVE & REPLACE EXISTING STRUCTURAL SECTION WITH 0.50' AC OVER 1.95' CAB OR 1.33' A.C. OVER COMPACTED NATIVE MATERIAL.
- R / S2 — REMOVE & REPLACE EXISTING STRUCTURAL SECTION WITH 0.5' AC OVER 1.48' CAB OR 1.33' A.C. OVER COMPACTED NATIVE MATERIAL.
- R / S3 — REMOVE & REPLACE EXIST STRUCTURAL SECTION WITH 0.50' A.C. OVER 1.65' CAB OR 1.18' A.C. OVER COMPACTED NATIVE MATERIAL.
- R / S4 — REMOVE & REPLACE EXIST STRUCTURAL SECTION WITH 0.35' A.C. OVER 1.45' CAB OR 0.95' A.C. OVER COMPACTED NATIVE MATERIAL.
- R / S5 — REMOVE & REPLACE EXIST STRUCTURAL SECTION WITH 1.33' A.C. OVER COMPACTED NATIVE MATERIAL.
- R / S6 — REMOVE & REPLACE EXIST. STRUCTURAL SECTION WITH 1.16' A.C. OVER COMPACTED NATIVE MATERIAL.
- CM — COLD MILL EXISTING A.C. ADJACENT TO GUTTER TO A DEPTH OF 0.05' BELOW THE GUTTER LIP AND WITH A STRAIGHT GRADE TO MEET EXISTING PAVEMENT IN A WIDTH EQUAL TO 5 FEET.
- OL — OVERLAY EXIST. PAVEMENT WITH VARIABLE THICKNESS A.C. (0.08' MIN.). PRIOR TO AC OVERLAY, FAILED PAVEMENT AREAS SHALL BE MARKED FOR REMOVAL IN THE FIELD. SEE SPECIAL PROVISIONS FOR AC PAVING REMOVAL.
- ADJ — ADJUST STORM DRAIN OR SEWER MANHOLE COVER TO GRADE.
- G.V. — ADJUST GATE VALVE BOX COVER TO GRADE.
- A.C. D/W — CONSTRUCT 4" THICK A.C. D/W APPROACH OVER COMPACTED NATIVE MATERIAL AS SHOWN ON PLAN. HIGH POINT SHALL BE 0.25' ABOVE AC BERM OR C&G FLOW LINE @ A DISTANCE OF 4'(ON FILL AREAS).
- REL / T — RELOCATE PALM TREE PER PARK & RECREATION DEPT. SPECIFICATION SEE SPEC. PROV.. CLASSES ARE THE SAME AS TREE REMOVAL. FOR RELOCATED PALM TREE LOCATION SEE SHEET 9.
- REM / T — REMOVE ENTIRE TREE. CLASS AS SHOWN ON PLAN..
- T-2 — PLANT JACARANDA TREE SEE SHT. 5 FOR LOCATION. SEE PARK & REC. NOTES & SPEC. PROV..
- ⚠ C / 66 — INSTALL 1-4" AND 1-2" PVC SCHEDULE 40 PIPE, WITH NYLON PULL CORDS, (SLEEVES ARE FOR FUTURE IRR. MAIN AND WIRING SYSTEM, RESPECTIVELY), AT A MINIMUM OF 24" BENEATH EXISTING PAVEMENT. TERMINATE ALL PIPE ENDS IN A BROOKS METER BOX (MODEL 3TL) OR CITY APPROVED EQUAL TWO FEET BEHIND CURB.

PARK AND RECREATION NOTES:

1. ALL RELATED WORK SHALL CONFORM TO THE CITY OF RIVERSIDE PARK AND RECREATION DEPT. STANDARDS AND CITY OF RIVERSIDE STREET TREE POLICIES.
2. WHEN CALLING FOR INSPECTIONS CONTACT THE STREET TREE INSPECTOR A MIN. OF 48 HOURS IN ADVANCE AT (714) 351-6126 TO SCHEDULE AN INSPECTION. A FIELD NOTICE WILL BE ISSUED AS A WRITTEN APPROVAL FOR EACH STAGE OF INSPECTION. A VERBAL APPROVAL WILL NOT BE ACCEPTABLE. INSPECTIONS ARE REQUIRED:
   a. AFTER COMPLETION OF FINAL GRADING OF THE LOTS AND WHEN ALL UTILITY SERVICES AND SEWER LATERALS HAVE BEEN MARKED, BUT PRIOR TO DIGGING PLANT PITS, ALL FINAL STREET TREE LOCATIONS ARE TO BE SPOTTED IN THE FIELD BY THE STREET TREE INSPECTOR.
   b. WHILE DIGGING PLANT PITS AND PLANTING/RELOCATING TREES.
   c. AFTER PLANTING AND ALL OTHER INDICATED OR SPECIFIED WORK HAS BEEN COMPLETED, FOR START OF MAINTENANCE.
   d. AT END OF MAINTENANCE PERIOD, THE CONTRACTOR SHALL CALL THE STREET TREE INSPECTOR AT (714) 351-6126 FOR A FINAL ACCEPTANCE INSPECTION IN ORDER TO BE RELEASED FROM MAINTENANCE. CONTRACTORS BONDS WILL NOT BE RELEASED UNTIL AFTER RECEIPT OF WRITTEN NOTIFICATION FROM THE CITY THAT THE TREES FINAL INSPECTION AND THE PARK AND RECREATION DEPT. IS ASSUMING MAINTENANCE RESPONSIBILITIES.
3. NONE
4. THE CONTRACTOR SHALL BE RESPONSIBLE TO ACCEPTABLY MAINTAIN ALL PLANTING FOR A MINIMUM PERIOD OF ONE (1) YEAR.
5. TREE PLANTING LOCATIONS ARE SHOWN ON PLANS AS ⊕. TREE TYPE INDICATED FOR EACH LOCATIONS SHALL BE AS FOLLOWS :

STREET NAME	COMMON NAME/ BOTANICAL NAME	MIN. SIZE	APPROX. SPACING	NO. REQUIRED
JURUPA (W'LY OF WILDERNESS ST.)	JACARANDA/ JACARANDA MIMOSIFOLIA	24" BOX	45'	6
JURUPA (E'LY OF CHESTER ST.)	MEXICAN FAN PALM/ WASHINGTON ROBUSTA	RELOCATE FROM ONSITE (45' HEIGHT)		3

6. BOTH A STREET TREE RELOCATION/REMOVAL PERMIT AS ISSUED BY THE PARK AND RECREATION DEPARTMENT AND A STREET OPENING PERMIT AS ISSUED BY THE PUBLIC WORKS DEPARTMENT ARE REQUIRED PRIOR TO COMMENCEMENT OF TREE RELOCATION AND/OR REMOVAL WORK. FOR ALL EXISTING TREES WITHIN WHAT WILL ULTIMATELY BE THE PUBLIC RIGHT-OF-WAY PAVEMENT AREA. BACKFILL OF ALL HOLES MUST BE INSPECTED BY THE PUBLIC WORKS INSPECTOR FOR PROPER COMPACTION.

NOTE:
IN THE INTEREST OF PUBLIC SAFETY AND MAINTENANCE, THE STREET TREE INSPECTOR SHALL HAVE THE AUTHORITY TO REVISE THE STREET TREE QUANTITIES AND LOCATIONS SHOWN ON APPROVED PLANS BASED UPON FIELD CONDITIONS FOUND AT THE TIME OF INSTALLATION OF THE TREES.

EXISTING UNDERGROUND & TOPOGRAPHY LEGEND

EXISTING UNDERGROUND UTILITIES:

- SANITARY SEWER — 8"S —
- WATER LINE — 6"W —
- STORM DRAIN — 24"SD —
- GAS LINE — 3"G —
- ABANDONED UTILITY — 6"G(ABAN'D.) —
- TELEPHONE CONDUIT — T — T —
- ELECTRICAL CONDUIT — E — E —
- ELECTROLIER LIGHTING CONDUIT — ELC —
- TRAFFIC SIGNAL — SIG — SIG —
- FIRE ALARM — F — F —

EXISTING TOPOGRAPHY:

- BLOCK WALL
- BOARD FENCE
- WIRE FENCE
- CHAIN LINK FENCE
- TOP OF SLOPE
- TOE OF SLOPE
- DIRECTION OF FLOW
- (S) SANITARY SEWER M.H.
- C.O. SANITARY SEWER CLEANOUT
- (D) STORM DRAIN M.H.
- (I) IRRIGATION WEIR
- (W) WATER M.H.
- (G) GAS M.H.
- (E) ELECTRIC M.H.
- (T) TELEPHONE M.H.
- WATER METER
- FIRE HYDRANT
- SPRINKLER HEAD
- VALVE
- AIR VALVE
- AIR VENT
- BUS STOP SIGN
- B.O. BLOW-OFF VALVE
- SP IRRIGATION STAND PIPE
- CONCRETE
- ASPHALT
- BUILDING
- EDGE OF PAVEMENT
- POLE & GUY ANCHOR
- PP POWER POLE
- T TELEPHONE POLE
- T TELEPHONE RISER
- J JOINT USE POLE
- PULL BOX
- TRAFFIC SIGN
- PARKING METER
- F FIRE ALARM BOX
- STREET NAME SIGN
- G GAS METER
- MAIL BOX
- FAUCET
- WALK-DON'T WALK PEDESTRIAN SIGNAL
- ELECTRICAL TEST STATION
- WHEEL STOP
- A.C. BERM
- PPB PEDESTRIAN PUSH BUTTON
- RAILROAD TRACKS
- RAILROAD SIGN
- RAILROAD SIGNAL
- TRAFFIC SIGNAL
- TRAFFIC SIGNAL ON MAST ARM
- TRAFFIC SIGNAL CONTROLLER
- TRAFFIC SIGNAL PRESSURE DETECTOR
- TRAFFIC SIGNAL LOOP DETECTOR
- STREET LIGHT & TRAFFIC SIGNAL ON MAST ARM
- STREET LIGHT (UPRIGHT)
- STREET LIGHT ON MAST ARM
- STEEL POST
- WOOD POST

IMPORTANT NOTICE
Section 4216/4217 of the Government Code requires a Dig Alert Identification Number to be issued before a "Permit to Excavate" will be valid. For your Dig Alert I.D. Number call Underground Service Alert
TOLL FREE 1-800-422-4133
Two working days before you dig.

✱ AS-BUILT 10-11-95 GH

BENCHMARK
H4-A, P.K. NAIL & TAG IN BASE OF ST. LIGHT ON N. SIDE OF JURUPA AVE. 40' W'LY. OF ROHR R.R. SPUR.
ELEVATION 788.314'

REGISTERED PROFESSIONAL ENGINEER — DUANE K. GREENWOOD — No. 43965 — Exp. 6/30/97 — CIVIL — STATE OF CALIFORNIA

ENGINEER IN Rresponsible CHARGE
DUANE K. GREENWOOD
R.C.E. No. 43965 expires 6/30/97
DATE 1/9/95

MARK	REVISIONS	APPR.	DATE
⚠1	ADD CONSTRUCTION NOTE (S4)	ORIG	2/1/95

DESIGNED BY DKG DRAWN BY LFH CHECKED BY DKG

CITY OF RIVERSIDE, CALIFORNIA
PUBLIC WORKS DEPARTMENT

APPROVED BY	BY	DATE
DEPUTY P.W. DIRECTOR	RVG	2/1/95
PRINCIPAL ENGINEER	JD	1/24/95
CHIEF P.W. INSPECTOR	LFH	1-12-95
TRAFFIC DIVISION		1/26/95
SURVEYOR	MSD	1-23-95
STREET SERVICES	RC	1/24/95
PARKS DEPARTMENT	MB	1-24-95

APPROVED BY
PUBLIC WORKS DIRECTOR
DATE 1/26/95

JURUPA AVE. WIDENING FROM VAN BUREN TO UPRR

ACCT. NO.: 432-541500-440302-30328

R-3291
SHEET 1 OF 14

HORIZ. SCALE: VERT. SCALE: PC 3502-S

INDEXED 3-23-95 GH

CONSTRUCTION NOTE:

(1) CONSTRUCT STAMPED CONCRETE IN MEDIAN ISLAND. COLOR SHALL BE ~~BROWN, A-25~~ * DESERT SAND ~~LA CRESCENTA~~ USE RUNNING BOND COBBLE STONE PATTERN. CHART C-11.

NOTE: EXIST. S.D. PIPE TO BE FIELD LOCATED PRIOR TO ISSUING GRADE SHEET.

CURVE DATA				
◇	△	R	L	T
1	180°00'00"	3'	9.42'	0'
2	17°00'00"	80'	23.73'	11.96'
3	9°34'38"	60'	98.14'	64.04'
4	19°00'00"	180'	59.69'	30.12'

CURB RETURN DATA
△ = 90° 00' 00"
R = 35'
T = 35'
L = 54.98'

CURB RETURN DATA
△ = 90° 00' 00"
R = 35'
T = 35'
L = 54.98'

* AS-BUILT 10-11-95 LH

REGISTERED PROFESSIONAL ENGINEER — DUANE K. GREENWOOD — No. 43965 — Exp. 6/30/97 — CIVIL — STATE OF CALIFORNIA

ENGINEER IN RESPONSIBLE CHARGE
DUANE K. GREENWOOD
R.C.E. No. 43065 expires 6/30/97
DATE 1/9/95

MARK	REVISIONS	APPR.	DATE
1	MODIFY CURB RETURN PROFILE		1/31/95
2	CHG. CURB REF. OFFSET @ VAN BUREN AND ADDED ACCESS DRIVEWAY @ RICKENBACKER		5/19/95
3	ADDED 8" R.V.C. SLEEVE		5/30/95

DESIGNED BY ---- DRAWN BY C.S. LFH CHECKED BY ----

CITY OF RIVERSIDE, CALIFORNIA
PUBLIC WORKS DEPARTMENT

APPROVED BY	BY	DATE
DEPUTY P.W. DIRECTOR		2/1/95
PRINCIPAL ENGINEER		1/10/95
CHIEF P.W. INSPECTOR		1-12-95
TRAFFIC DIVISION		1/13/95
SURVEYOR		1.13.95
STREET SERVICES		1/13/95
PARKS DEPARTMENT		1-12-95

APPROVED BY
PUBLIC WORKS DIRECTOR
DATE 1/26/95

JURUPA AVE WIDENING FROM VAN BUREN TO UPRR

ACCT. NO.: 432-541500-440302-30328

R-3291

SHEET 2 OF 14

HORIZ. SCALE: 1" = 40' VERT. SCALE: 1" = 4'

PC 3502-S

INDEXED 3-23-95 LH

EXISTING SURFACE @ ℄ JURUPA AVE.

EXIST. T.C. @ 43' LT. @ 0.8%

PROP. T.C. @ 43' LT.

PROP. T.C. @ 45° LT.

EXIST. T.C. @ 0.95%

EXISTING SURFACE @ ℄ JURUPA AVE.

PROP. T.C. @ 43' RT.

EXISTING T.C. @ 43' RT. @ 0.5%

EXIST. T.C. @ 43' RT. @ 0.4%

PROP. T.C. @ 43' RT.

FUT. T.C. @ 0.36%

754
750
752
748
746

18 19 20 21 22 23 24 25 26 27 28 29 30 31

CURB RETURN DATA

△ = 79°44'52"
R = 35'
T = 29.24'
L = 48.72'

CURB RETURN DATA

△ = 97°18'08"
R = 35'
T = 39.77'
L = 59.44'

CURB RETURN DATA

△ = 100°15'08"
R = 35'
T = 41.90'
L = 61.24'

WINTERHAVEN

ACORN ST.

JURUPA AVENUE

℄ N80°01'00"E

STA. 18+00

STA. 31+00

MATCH LINE

MATCH LINE

EXIST. C & G

EXIST. C & G (PER R-3035)

EXIST C&G (PER R-2370)

EXIST. C&G

57" SD [G-495] EXIST C&G PER R-2672

END AC COLD MILLING

MEET EXIST. C&G, BEGIN AC COLD MILLING 18+92.50

MEET EXIST. & BEGIN STREET SECTION C&G & S/W 24+50 BEGIN C&G & S/W REMOVAL END AC COLD MILLING

MEET EXIST. END AC COLD MILLING 8+75

BEG. S/W @ B.C.R. 9+29.98

PCC D/W 23+78.07 ℄ JURUPA AVE.

EXISTING SURFACE @ ℄ JURUPA AVE.

28+67.02 JURUPA AVE. = 10+00 ACORN ST.

28+97.23

CAUTION! HIGH PRESSURE GAS

CONSTRUCTION NOTE:

(3) THIS AREA IS LANDSCAPED AND HAS AN ACTIVE SPRINKLER SYSTEM. CONTRACTOR SHALL RESTORE LANDSCAPED AND IRRIGATED AREAS TO PRIOR CONDITION SUCH THAT ADEQUATE LANDSCAPING AND IRRIGATION COVERAGE ARE PROVIDED.

REGISTERED PROFESSIONAL ENGINEER
DUANE K. GREENWOOD
No. 43965
Exp. 6/30/97
CIVIL
STATE OF CALIFORNIA

ENGINEER IN RESPONSIBLE CHARGE
DUANE K. GREENWOOD
R.C.E. No. 43065 expires 6/30/97
DATE 1/9/95

MARK | REVISIONS | APPR. | DATE

DESIGNED BY ____ DRAWN BY C.S. L.F.H. CHECKED BY ____

CITY OF RIVERSIDE, CALIFORNIA
PUBLIC WORKS DEPARTMENT

APPROVED BY	BY	DATE
DEPUTY P.W. DIRECTOR		1/11/95
PRINCIPAL ENGINEER		1/13/95
CHIEF P.W. INSPECTOR		1-12-95
TRAFFIC DIVISION		1-13-95
SURVEYOR		1-12-95
STREET SERVICES		1/10/95
PARKS DEPARTMENT		1-12-95

APPROVED BY ____ *PUBLIC WORKS DIRECTOR
DATE 1/26/95

JURUPA AVE WIDENING FROM VAN BUREN TO UPRR

ACCT. NO.: 432-541500-440302-30328

R-3291

SHEET 3 OF 14

PC 3502-S

HORIZ. SCALE: 1" = 40' VERT. SCALE: 1" = 4'

* AS-BUILT 10-11-95 LFH

INDEXED 3-23-95 LFH

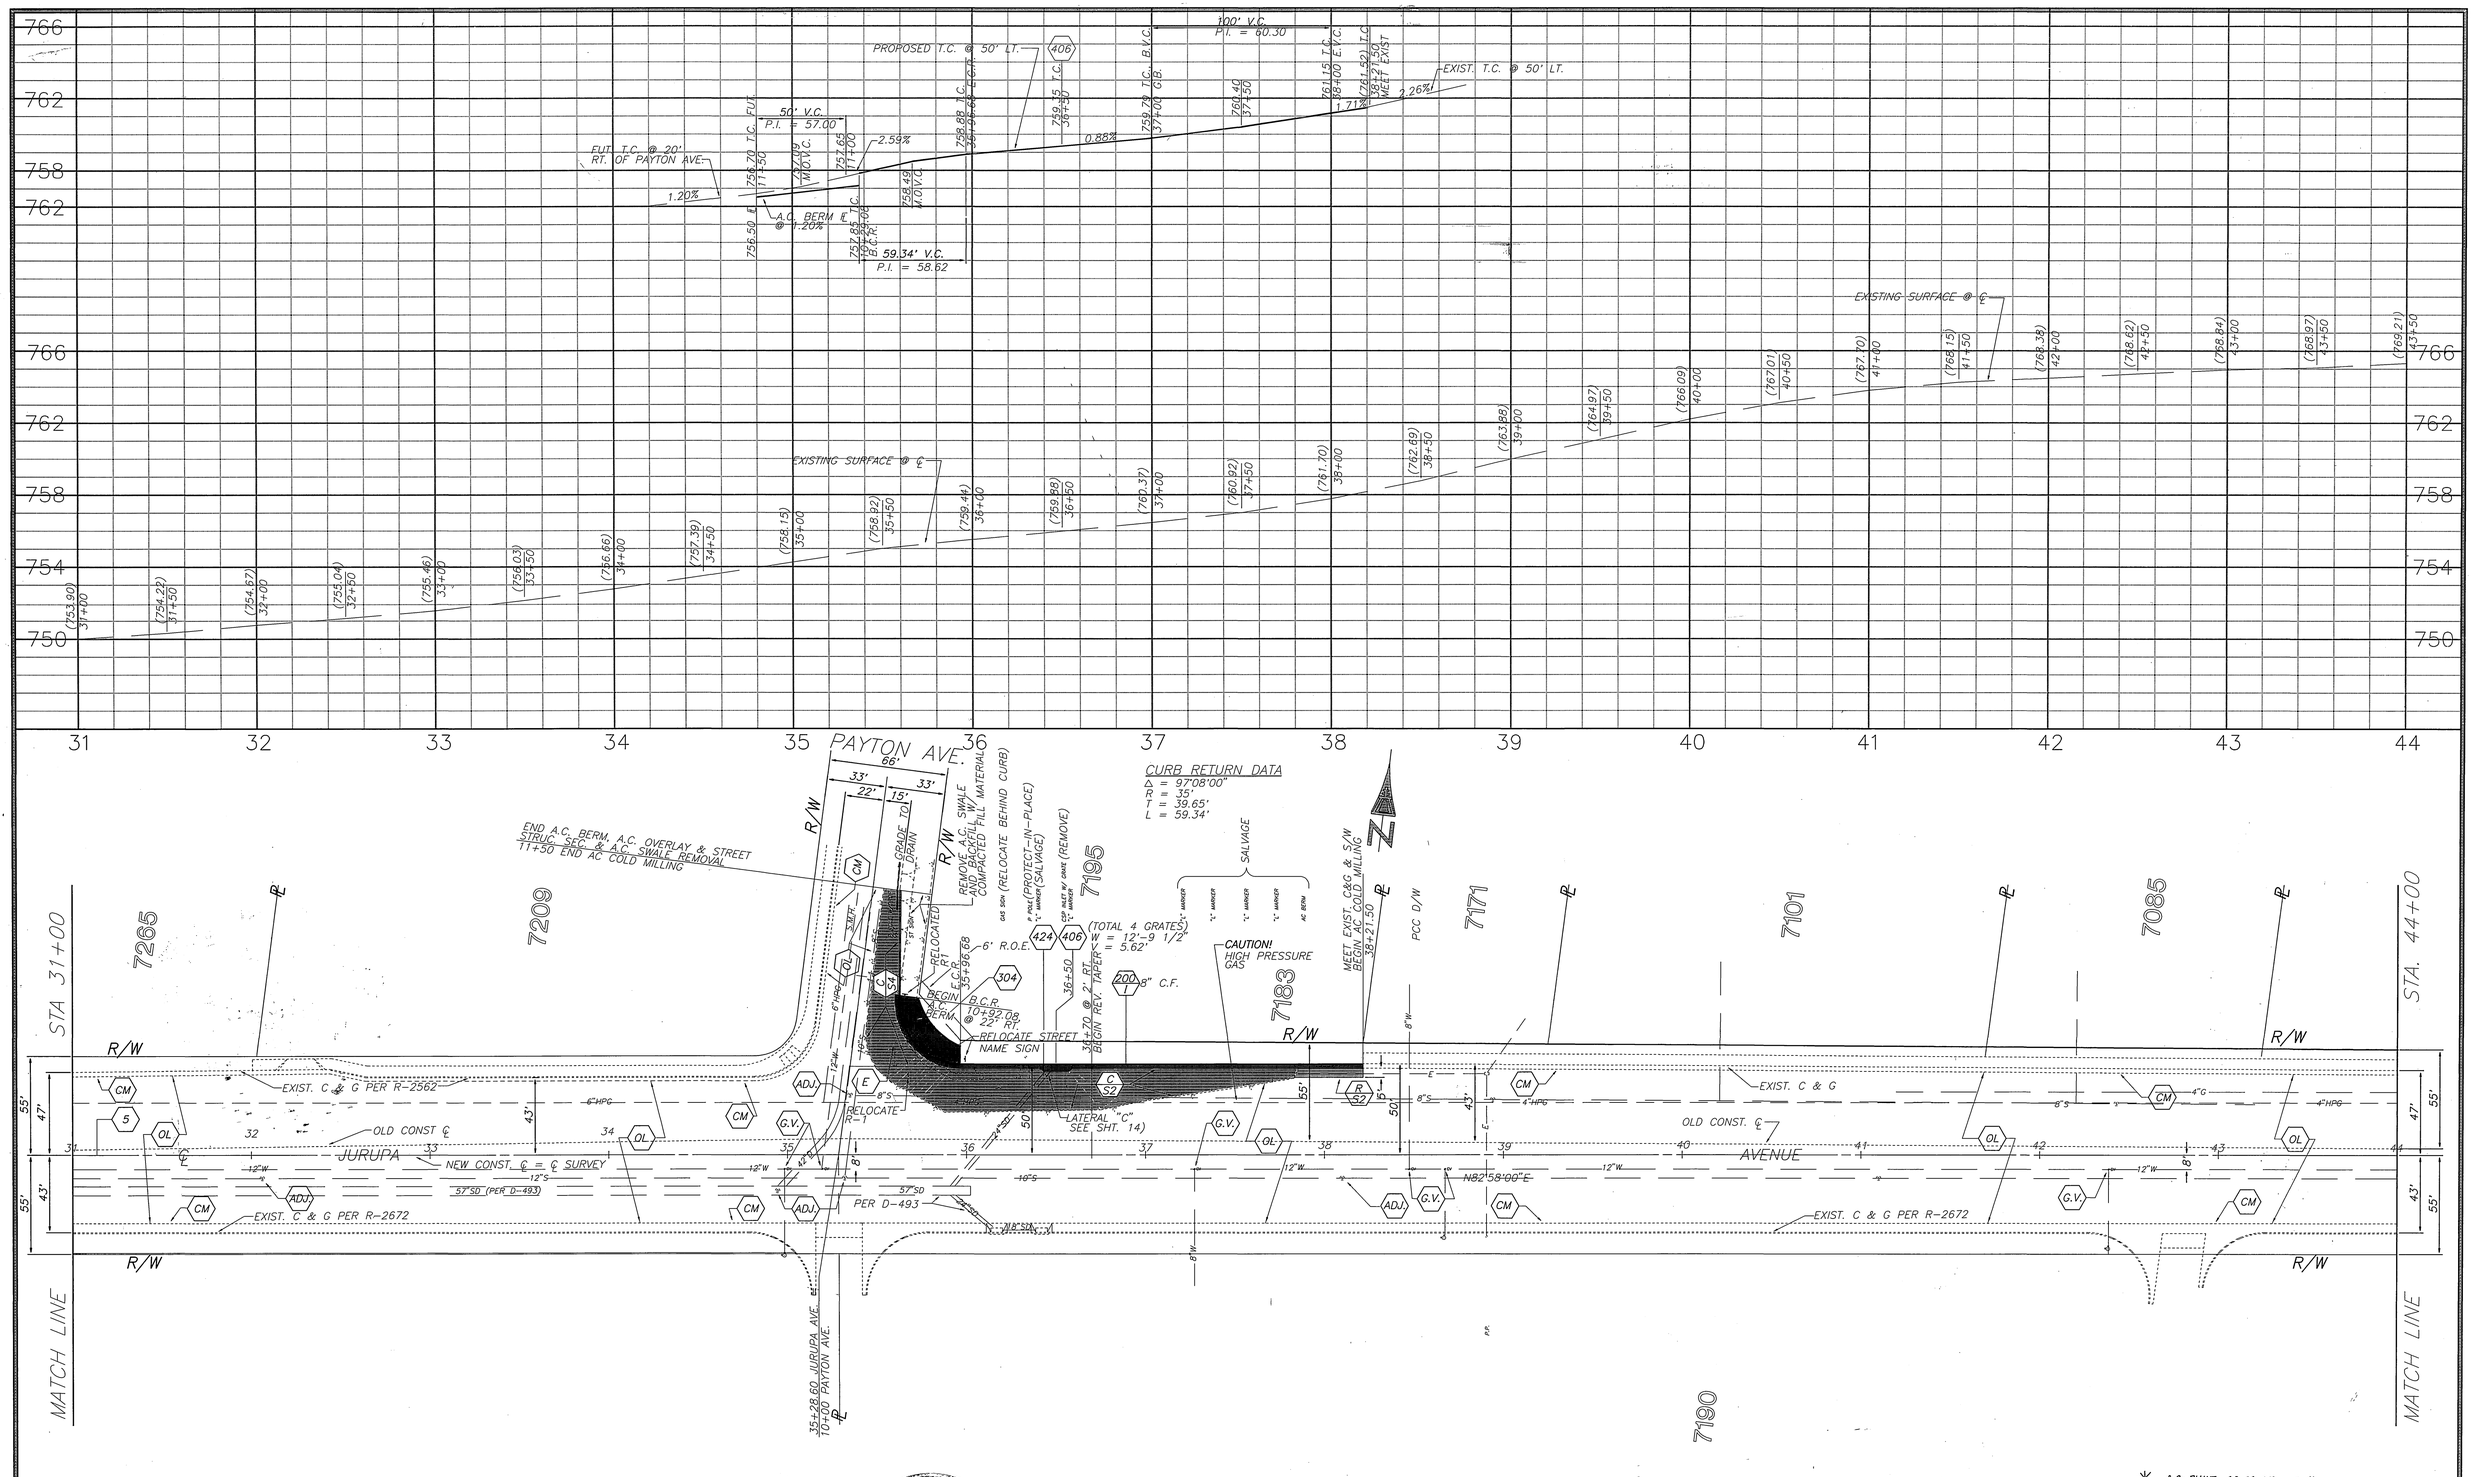

✳ AS-BUILT 10-11-95 GH

REGISTERED PROFESSIONAL ENGINEER
DUANE K. GREENWOOD
No. 43965
Exp. 6/30/97
CIVIL
STATE OF CALIFORNIA

ENGINEER IN RESPONSIBLE CHARGE

DUANE K. GREENWOOD
R.C.E. No. 43965 expires 6/30/97

DATE 1/9/95

MARK	REVISIONS	APPR.	DATE

DESIGNED BY DKH DRAWN BY C.S. LFH CHECKED BY DKH

CITY OF RIVERSIDE, CALIFORNIA
PUBLIC WORKS DEPARTMENT

APPROVED BY	BY	DATE
DEPUTY P.W. DIRECTOR		1/11/95
PRINCIPAL ENGINEER		1/12/95
CHIEF P.W. INSPECTOR		1/12/95
TRAFFIC DIVISION		1/13/95
SURVEYOR		1/17/95
STREET SERVICES		1/17/95
PARKS DEPARTMENT		1/23/95

APPROVED BY
PUBLIC WORKS DIRECTOR
DATE 1/26/95

JURUPA AVE WIDENING FROM VAN BUREN TO UPRR

HORIZ. SCALE: 1" = 40' VERT. SCALE: 1" = 4'

ACCT. NO.: 432-541500-440302-30328

R-3291


PC 3502-S

INDEXED 3-23-95 GH

CONSTRUCTION NOTE:

(3) THIS AREA IS LANDSCAPED AND HAS AN ACTIVE SPRINKLER SYSTEM. CONTRACTOR SHALL RESTORE LANDSCAPED AND IRRIGATED AREAS TO PRIOR CONDITION SUCH THAT ADEQUATE LANDSCAPING AND IRRIGATION COVERAGE ARE PROVIDED.

(T-2) PLANT JACARANDA TREE.

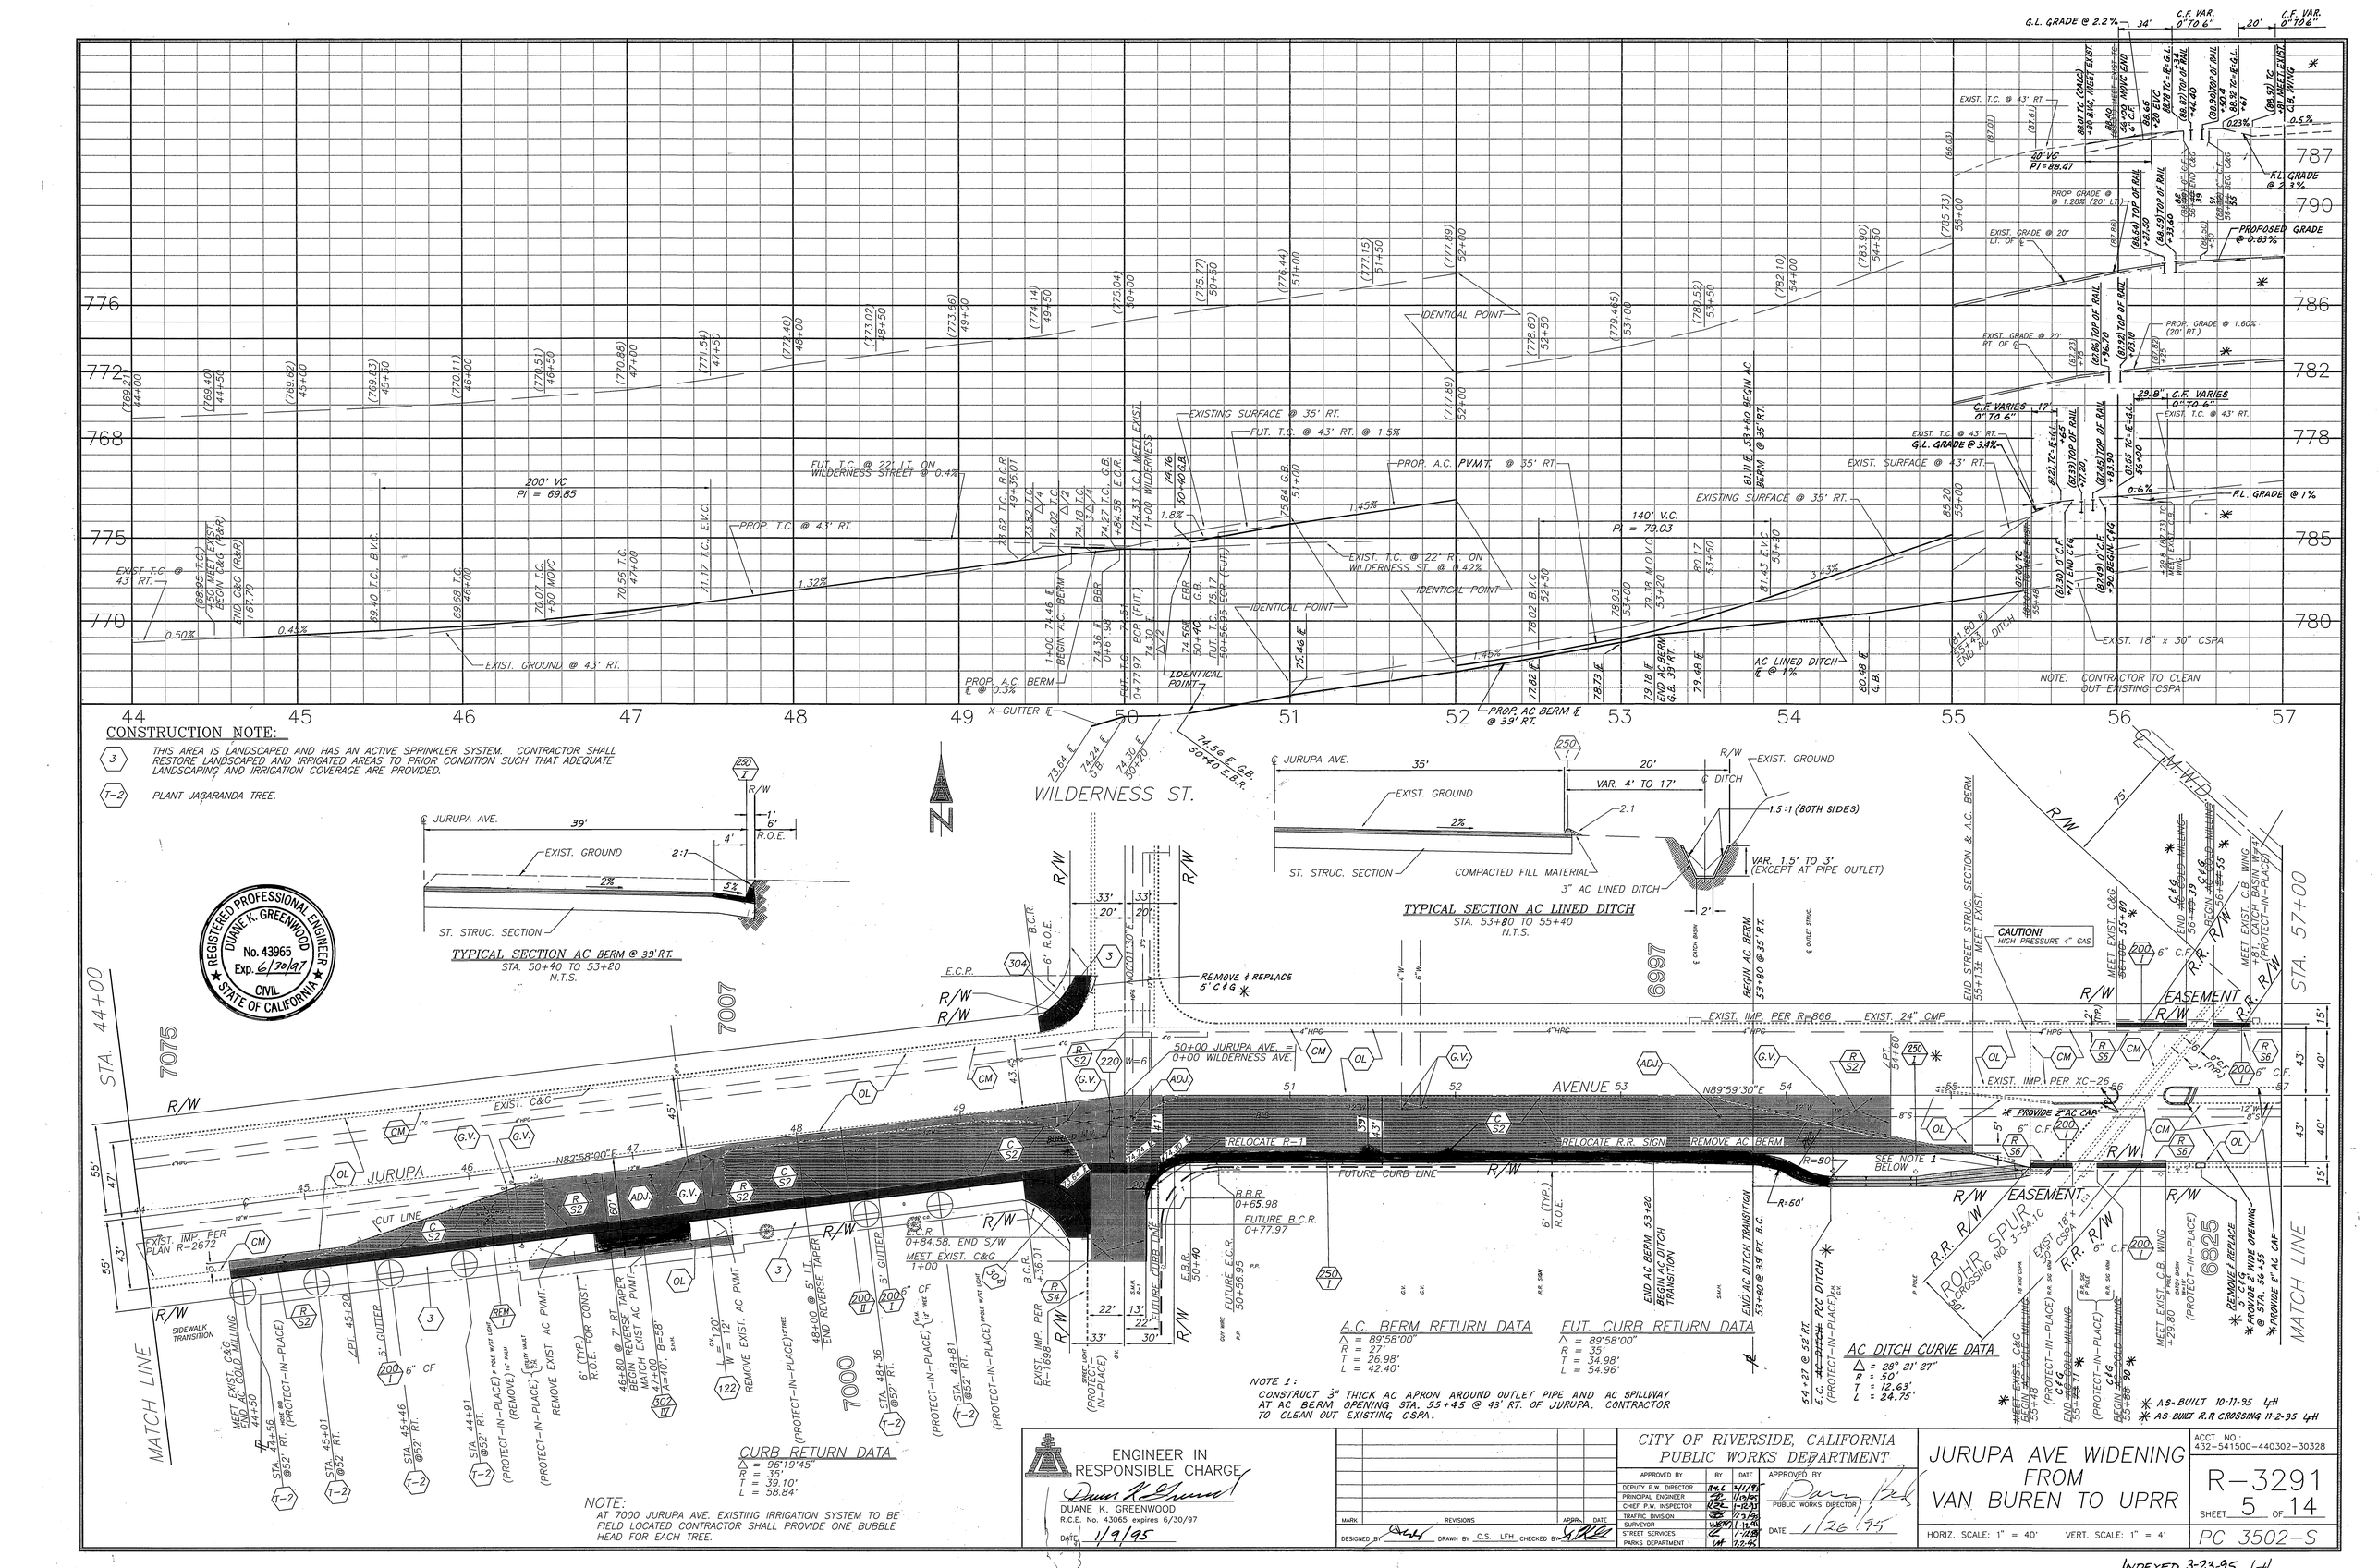
STA. 44+00
STA. 57+00
MATCH LINE
MATCH LINE
JURUPA
WILDERNESS ST.
AVENUE 53
7075
7007
7000
6997
6825
N87°58'00"E
N89°59'30"E
EXIST. IMP. PER PLAN R-2612
EXIST. IMP. PER R=866
EXIST. IMP. PER XC-26
EXIST. 24" CMP
EXIST. GROUND @ 4.3' RT.
EXIST. SURFACE @ 43' RT.
EXIST. SURFACE @ 35' RT.
EXISTING SURFACE @ 35' RT.
EXISTING SURFACE @ 22' RT. ON WILDERNESS ST. @ 0.42%
FUT. T.C. @ 22' LT. ON WILDERNESS STREET @ 0.42%
FUT. T.C. @ 43' RT. @ 1.5%
PROP. T.C. @ 43' RT.
PROP. A.C. PVMT. @ 35' RT.
PROP. A.C. BERM E @ 0.3%
PROP. AC BERM E @ 39' RT.
200' VC PI = 69.85
140' V.C. PI = 79.03
IDENTICAL POINT
EXIST. T.C. @ 43' RT.
EXIST. T.C. @ 22' RT. ON WILDERNESS ST. @ 0.42%
EXIST. T.C. @ 43' RT.
EXIST. 18" x 30" CSPA
AC LINED DITCH @ 1%
PROP. GRADE @ 1.28% (20' LT.)
PROP. GRADE @ 1.60% (20' RT.)
PROPOSED GRADE @ 0.83%
EXIST. GRADE @ 20' LT. OF ℄
EXIST. GRADE @ 20' RT. OF ℄
G.L. GRADE @ 2.2%
G.L. GRADE @ 3.4%
F.L. GRADE @ 2.3%
F.L. GRADE @ 1%
C.F. VAR. 0" TO 6"
C.F. VARIES 0" TO 6"
0.50%
0.45%
1.32%
1.8%
1.45%
1.46%
3.43%
0.5%
0.23%
0.6%
EXIST. GROUND @ 4.3' RT.
PROP. A.C. BERM E @ 0.3%
X-GUTTER ℄
PROP. AC BERM E @ 39' RT.
EXIST. T.C. @ 43' RT.
EXIST. GRADE @ 20' LT. OF ℄
EXIST. GRADE @ 20' RT. OF ℄
EXIST. SURFACE @ 43' RT.
EXISTING SURFACE @ 35' RT.
NOTE: CONTRACTOR TO CLEAN OUT EXISTING CSPA
JURUPA AVE.
EXIST. GROUND
ST. STRUC. SECTION
COMPACTED FILL MATERIAL
3" AC LINED DITCH
1.5:1 (BOTH SIDES)
VAR. 1.5' TO 3' (EXCEPT AT PIPE OUTLET)
TYPICAL SECTION AC LINED DITCH
STA. 53+80 TO 55+40
N.T.S.
TYPICAL SECTION AC BERM @ 39' R.T.
STA. 50+40 TO 53+20
N.T.S.
A.C. BERM RETURN DATA
Δ = 89°58'00"
R = 27'
T = 26.98'
L = 42.40'
FUT. CURB RETURN DATA
Δ = 89°58'00"
R = 35'
T = 34.98'
L = 54.96'
AC DITCH CURVE DATA
Δ = 28° 21' 27"
R = 50'
T = 12.63'
L = 24.75'
CURB RETURN DATA
Δ = 96°19'45"
R = 35'
T = 39.10'
L = 58.84'
REMOVE & REPLACE 5' C&G
RELOCATE R=1
RELOCATE R.R. SIGN
REMOVE AC BERM
FUTURE CURB LINE
FUTURE E.C.R. 50+56.95
FUTURE B.C.R. 0+77.97
E.B.R. 50+40
B.B.R. 0+65.98
B.C.R. 49+36.01
E.C.R. 0+84.58
END AC BERM 53+20
BEGIN AC DITCH TRANSITION
END AC DITCH TRANSITION 53+80 @ 39' RT. B.C.
54+27 @ 52' RT. E.C. AC DITCH (PROTECT-IN-PLACE)
PROP. 6" C&G
PROP. 5' C&G
PROVIDE 2" AC CAP @ STA. 56+55
PROVIDE 2" AC CAP
REMOVE & REPLACE 5' C&G @ STA. 56+55
PROVIDE 6" WIDE OPENING
CUT LINE
SIDEWALK TRANSITION
EXIST. C&G
EXIST. 18" x 30" CSPA
EXIST. 15" x 23" CSPA
ROHR SPUR
R.R. R/W
EASEMENT
EASEMENT
R/W
R/W
R/W

EXISTING SURFACE @ ℄

IDENTICAL POINT

PROP. A.C. BERM E @ 26' RT.

802.45 +50

802.95 63+00 G.B.

30' (TRANSITION)

96.54 E BEGIN A.C. BERM @ 30' RT. +85

97.12 CALC. 61+00

97.5

614.15 G.B.

98.66 +50

810.47 62+00

3.05%

EXIST. FLOWLINE @ 43' RT. @ 2%

EXIST. SURFACE @ 26' RT.

MEET EXIST. C&G +2.40' (614.55' E)

EXISTING SURFACE @ ℄

EXISTING SURFACE @ 26' RT.

PROP. A.C. BERM E @ 26' RT.

810.04 65+00 G.B.

812.65 66+00 G.B.

813.46 +50

814.43 67+00

2.61%

MEET EXIST. C&G +2.71' (614.59' E)

EXIST. E 43' RT. @ 1.2%

802 798 794 790 — 814 810 806 802 798 794 790

57 58 59 60 61 62 63 64 65 66 67 68 69 70

JASMINE ST.

MATCH LINE

COLUMBUS AVE.

6611

6855

6600

6825

STA 57+00

STA 70+00

EASEMENT

EXIST. IMP. PER R-540

EXIST. IMP. PER R-656

JURUPA AVENUE

CUT LINE

R=3437.87'

60+40.94 B.C.

BEGIN A.C. BERM @ 30' RT. +85 END A.C. SWALE

BEGIN STREET STRUC. SECTION 61+15 ℄PT. BEGIN A.C. BERM 26' RT.

63+30.52 P.O.C.

69+14.46

℄ EARTHEN SWALE

96.50 @ 30.78' RT. E

96.50 @ 34.75' RT.

INSTALL TYPE "L" MARKERS

CONSTRUCT A.C. SWALE (INSTALL TYPE "L") CONSTRUCT 4" THICK A.C. FOR DRAINAGE

6' (TYP.) R.O.E. FOR CONST.

℄PT. 67+00 END A.C. BERM

MEET EXIST. A.C. BERM 67+21 END A.C. COLD MILLING

CAUTION! HIGH PRESSURE 30" GAS

AS-BUILT 10-11-95 GH

INDEXED 3-23-95 GH

REGISTERED PROFESSIONAL ENGINEER DUANE K. GREENWOOD No. 43965 Exp. 6/30/97 CIVIL STATE OF CALIFORNIA

ENGINEER IN RESPONSIBLE CHARGE

DUANE K. GREENWOOD

R.C.E. No. 43965 expires 6/30/97

DATE 1/9/95

MARK | REVISIONS | APPR | DATE

DESIGNED BY ____ DRAWN BY C.S., LFH CHECKED BY DKG

CITY OF RIVERSIDE, CALIFORNIA
PUBLIC WORKS DEPARTMENT

APPROVED BY	BY	DATE
DEPUTY P.W. DIRECTOR	DKG	1/11/95
PRINCIPAL ENGINEER	JS	1/13/95
CHIEF P.W. INSPECTOR	CSS	1-13-95
TRAFFIC DIVISION	[illegible]	1/13/95
SURVEYOR	[illegible]	1/13/95
STREET SERVICES	RCS	1/24/95
PARKS DEPARTMENT	GH	2-2-95

APPROVED BY ____ PUBLIC WORKS DIRECTOR

DATE 1/26/95

JURUPA AVE WIDENING FROM VAN BUREN TO UPRR

HORIZ. SCALE: 1" = 40' VERT. SCALE: 1" = 4'

ACCT. NO.: 432-541500-440302-30328

R-3291

SHEET 6 OF 14

PC 3502-S

PROP. SURFACE @ ℄

EXISTING SURFACE @ ℄

IDENTICAL POINT

IDENTICAL POINT

EXIST. T.C. 43' RT. @ 1.52%

PROP. A.C. BERM ℄ @ 26' RT.

EXISTING SURFACE @ 26' RT.

AC PAVEMENT TRANSITION 26' RT. TO 31' RT.

EXIST. SURFACE @ 31' RT.

PROP. A.C. BERM ℄ @ 31' RT.

EXISTING SURFACE @ 31' RT.

PROP. A.C. BERM ℄ @ 31' RT.

EXISTING SURFACE @ 31' RT.

EXIST C&G FLOW LINE

1.68%
0.78%
1.59%
1.70%
1.89%
1.92%
2.79%

13.96 (℄)
14.46 (TC)
14.96 BEGIN A.C. BERM
13.67
72+86 G.B.
11.95
74+00 G.B.
10.15
75+00 G.B.
8.26
76+00 G.B.
7.34
76+50 G.B.
06.37
77+00
05.45
77+50
04.37
78+00 G.B.
04.37
78+00 G.B.
02.39
79+00 G.B.
800.28
800.01 BBR
Δ 14
799.93
799.89
Δ 14
799.98
9+18.54 E.B.R.
END AC BERM
9+00
801.38 T.P.
8+75 MEET EXIST.
798.0
81+00 G.B.
797.15
81+50
798.32
82+00
(95.16 G.B.)
82+50 GUTTER LIP
(94.69) ℄ MEET EXIST. C&G
+60 END AC BERM
MEET EXIST. EP
799.54
94+25 (799.54)
BEGIN AC BERM
799.00 BCR
94+60 (799.91)
799.81
Δ 14
799.71
Δ 14
798.60
80+76.40 EBR

STA 70+00
STA. 83+00
MATCH LINE
MATCH LINE
R/W
℄
EXIST. IMP. PER R-258C
EXIST. IMP. PER R-656
EXIST. IMP. PER. R-258B
4"HPG
BEGIN STREET STRUC. SECTION 72+86
JURUPA
AVENUE
ORDWAY ST.
REPUBLIC ST.
MT. VIEW AVE.
ORDWAY ST. ℄
REPUBLIC ℄
12'W
10'S
3'G
6'S
4'G
55'
43'
40'
31'
26'
R=3437.87'
N58°06'45"E
76+50.84 EXIST. IMP. PER. R-165C
79+00 END AC PVMT. TRANSITION @ 31' RT. OF CONST. ℄ SURVEY ℄
76+50 BEGIN AC PVMT. TRANSITION @ 26' RT. OF CONST. ℄ SURVEY ℄
80+69.74 JURUPA AVE. ℄ 10+00 MT. VIEW AVE.
9+18.54 EBR END AC BERM
9+60.45 BBR BEGIN AC BERM
81+43.16 E.C.
81+17.16 B.C.
82+08.82 E.C.
82+37 END STREET STRUC. SECTION
℄ PT. A.C. BERM
6" R.O.E.
TRIM ROW OF OLEANDERS
END AC COLD MILLING 81+18
END AC COLD MILLING
BEGIN AC COLD MILLING BEGIN A.C. BERM & MEET EXIST. C&G 72+53
END AC COLD MILLING 82+50 MEET EXIST. C&G
END A.C. BERM @ 43' RT. 82+60 MEET EXIST C&G
END AC DIKE/OVERLAY MEET EXIST.
6" R.O.E.
5' HIGH WIRE FENCE (RELOCATE WIRE FENCE TO BEHIND R/W)
MEET EXIST. EP
8.83' TRT.
@ 43' RT.
(PROTECT-IN-PLACE) 30' WALKBOX
(PROTECT-IN-PLACE) 30' WALKBOX
(PROTECT-IN-PLACE) ST LIGHT
(REMOVE) 6' CONC RUSH
(RELOCATE) WALKBOX

EXISTING SURFACE @ 26' LT.

E.P. @ 15' RT. OF FREMONT AVE.

PROP. A.C. BERM ℄ LT. OF CONST. ℄

EXISTING SURFACE @ 26' LT.

IDENTICAL POINT

EXIST. R.R. TRACK

CURB LINE VARIES 32' TO 43' LT. OF CONST. ℄

EXIST. T.C. @ 32' LT.

PROP. T.C. LT. ℄ JURUPA AVE.

EXIST. E.P. @ 15 RT.

PROPOSED SURFACE @ CONST. ℄

EXISTING SURFACE @ CONST. ℄

IDENTICAL POINT

PROPOSED SURFACE @ CONST. & SURVEY ℄

EXISTING SURFACE @ SURVEY ℄

EXIST. SURVEY & CONST. ℄

A.C. BERM ℄ RT. OF FREMONT AVE.

PROP. A.C. BERM ℄ @ 26' RT. OF CONST. ℄

EXISTING SURFACE @ 26' RT.

PROP. A.C. BERM ℄ @ RT. OF CONST. ℄

IDENTICAL POINT

EXISTING SURFACE @ 26' RT.

PROP. A.C. BERM ℄ @ 26' RT. OF SURVEY ℄

PROP. A.C. BERM ℄ @ 31' RT. OF CONST. CENTERLINE

EXIST. C&G FLOW LINE @ 1.55%

83 84 85 86 87 88 89 90 91 92 93 94 95

796 792 788 784 780

AC BERM RETURN DATA

△ = 111°42'54"
R = 30'
T = 44.24'
L = 58.49'

AC BERM RETURN DATA

△ = 89°14'08"
R = 25'
T = 24.67'
L = 38.94'

AC BERM RETURN DATA

△ = 100°48'00"
R = 20'
T = 24.18'
L = 35.19'

AC BERM RETURN DATA

△ = 65°04'15"
R = 30'
T = 19.14'
L = 34.07'

AC BERM RETURN DATA

△ = 83°03'14"
R = 20'
T = 17.71'
L = 28.99'

CONST. ℄ CURVE DATA

△ = 35°59'28"
R = 1251.70'
T = 406.60'
L = 786.27'

AC BERM RETURN DATA

△ = 83°30'10"
R = 20'
T = 18.60'
L = 29.15'

AC BERM RETURN DATA

△ = 94°14'02"
R = 20'
T = 21.50'
L = 32.89'

CONSTRUCTION NOTE:

(6) REMOVE EXISTING AC PAVEMENT BETWEEN RIGHT-OF-WAY AND CURB & GUTTER.

* AS-BUILT 10-11-95 GH

FOR INTERSECTION DETAIL SEE SHT. 10

VACATED ESSEX ST. R/W

UPRR R/W

VAC. DEXTER STREET R/W

VAC. ESSEX STREET

ESSEX ST.

CHESTER ST.

DEXTER AVENUE

JURUPA AVE.

COLUMBUS ST.

FREMONT AVE.

MATCH LINE STA. 83+00

MATCH LINE STA. 95+00

ADDRESSES ON VANESSA ST.

6091 6087 6079 6075 6023 6009 5971 6011 6007 6003 5999 5986 6001 6005 6027 6031 6035 6039 6043 6047 6051 6054 6062 6070 6086 6090 6010 6014 6018 6022 6026 6030 6034 6038 6042 6046 6050 6058 6066 6074 6078 6082 6094 6098 6102 

CURB LINE VARIES 32' TO 43' LT. OF CONST. ℄

PROP. T.C. LT. OF ℄ JURUPA AVE.

EXISTING T.C. @ 43' LT.

PROPOSED SURFACE @ CONST. & SURVEY ℄

EXISTING SURFACE @ SURVEY ℄

IDENTICAL POINT

EXIST. MEDIAN T.C., 4 LT.

PROP. RT. MEDIAN T.C.

PROP. A.C. BERM ℄ @ 28' RT.

EXISTING C&G @ 43' RT.

EXISTING SURFACE @ 26' RT.

A.C. BERM ℄ @ 28' RT.

A.C. BERM ℄ @ 32' RT.

EXIST. C&G ℄ @ 18' LT. OF SHEPPARD ST.

A.C. BERM ℄ @ 18' RT. OF FLORENCE ST.

A.C. BERM ℄ @ 18' LT. OF FLORENCE ST.

A.C. BERM ℄ @ 18' LT. OF WILLIAMS ST.

A.C. BERM ℄ 18' RT. OF WILLIAMS ST.

0.96%

0.61%

0.32%

0.15%

0.33%

CONSTRUCTION NOTES:

(2) INSTALL 2" x 4" REDWOOD HEADER.

(A87 E) CONSTRUCT AC DIKE PER STATE STD. A87, TYPE E.

(6) REMOVE EXISTING AC PAVEMENT BETWEEN RIGHT-OF-WAY AND CURB & GUTTER.

(9) RELOCATED PALM TREE, SEE PARK & REC. NOTES ON SHEET 1.

PAID FOR BY AGREEMENT BETWEEN OWNER & CONT'R

VAC. INDUSTRIAL AVE

STA. 95+00

MATCH LINE

JURUPA AVENUE

FLORENCE ST.

WILLIAM ST

SHEPPARD ST.

U.P.R.R. R/W

ADDRESSES ON VANESSA ST.

CURVE DATA CONST. ℄
Δ = 2°44'47"
R = 2000'
T = 47.94'
L = 95.87'

AC BERM RETURN DATA
Δ = 85°46'57"
R = 20'
T = 18.58'
L = 29.94'

AC BERM RETURN DATA
Δ = 94°13'03"
R = 20'
T = 21.53'
L = 32.89'

AC BERM RETURN DATA
Δ = 85°47'18"
R = 20'
T = 18.58'
L = 29.95'

AC BERM RETURN DATA
Δ = 94°12'42"
R = 20'
T = 21.53'
L = 32.89'

AC BERM RETURN DATA
Δ = 40°54'32"
R = 27'
T = 10.67'
L = 19.28'

STORM DRAIN C.O. BOX- 2'SQ. 7' FROM C.F.- 3'FROM E'LY SIDE OF C.B.- NOT ADJUSTED TO GRADE PER MIKE KIRBY

4" A.C. MATCH-UP LINE

✳ AS-BUILT 10-11-95 LH

REGISTERED PROFESSIONAL ENGINEER — DUANE K. GREENWOOD — No. 43965 — Exp. 6/30/97 — CIVIL — STATE OF CALIFORNIA

ENGINEER IN RESPONSIBLE CHARGE
DUANE K. GREENWOOD
R.C.E. No. 43965 expires 6/30/97
DATE 11/9/95

MARK	REVISIONS	APPR.	DATE
⚠	MODIFY TREE LOCATIONS & D/W A.P.	DKG	2/1/95

DESIGNED GREENWOOD DRAWN BY LFH CHECKED BY DKG

CITY OF RIVERSIDE, CALIFORNIA
PUBLIC WORKS DEPARTMENT

APPROVED BY	BY	DATE
DEPUTY, P.W. DIRECTOR	RMG	2/1/95
PRINCIPAL ENGINEER	JR	11/14/97
CHIEF P.W. INSPECTOR	RRE	1-12-95
TRAFFIC DIVISION		11-3-95
SURVEYOR	MGW	11.8.95
STREET SERVICES	RE	11/14/95
PARKS DEPARTMENT	LM	12-2-95

APPROVED BY _____ PUBLIC WORKS DIRECTOR
DATE 1/26/95

JURUPA AVE WIDENING FROM VAN BUREN TO UPRR

ACCT. NO.: 432-541500-440302-30328

R-3291

SHEET 9 OF 14

HORIZ. SCALE: 1" = 40' VERT. SCALE: 1" = 4'

PC 3502-S

INDEXED 3-23-95 LH

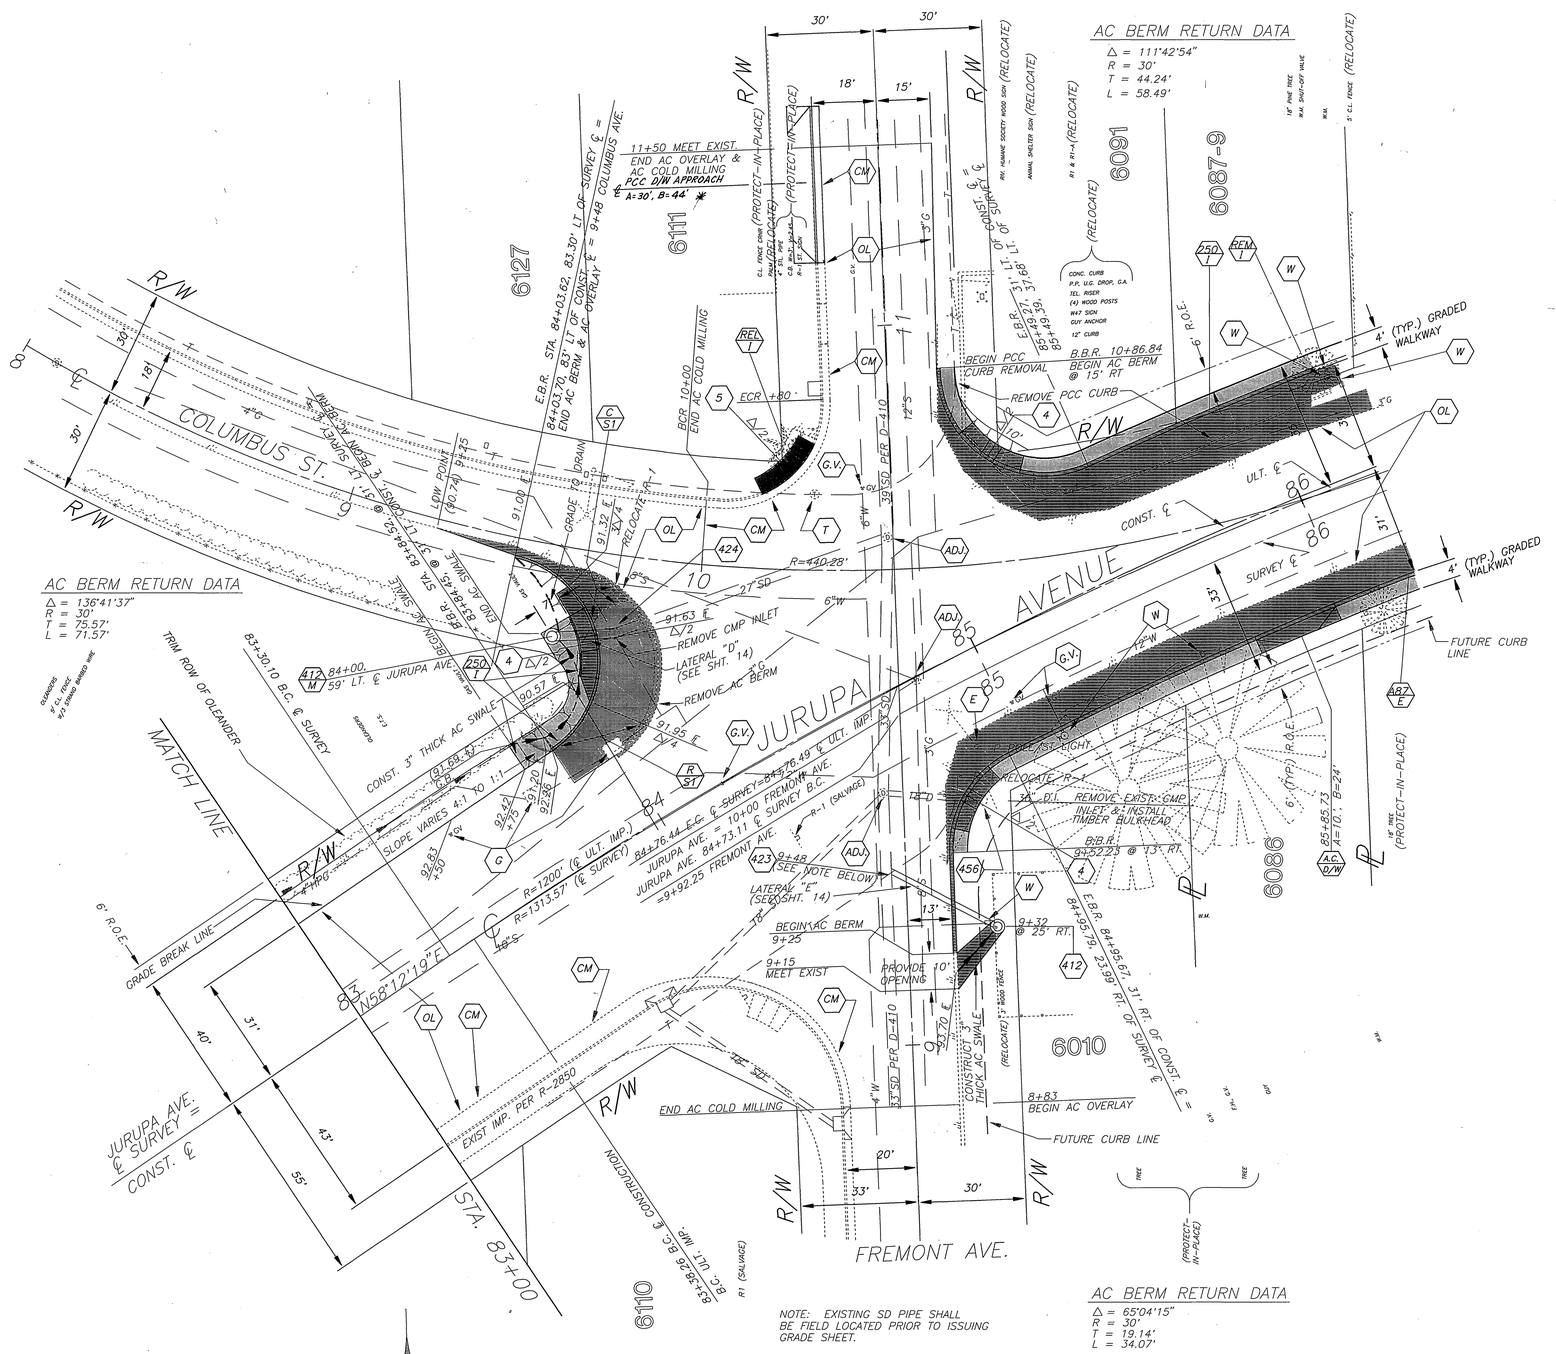
AC BERM RETURN DATA
Δ = 111°42'54"
R = 30'
T = 44.24'
L = 58.49'
AC BERM RETURN DATA
Δ = 136°41'37"
R = 30'
T = 75.57'
L = 71.57'
AC BERM RETURN DATA
Δ = 65°04'15"
R = 30'
T = 19.14'
L = 34.07'
COLUMBUS ST.
JURUPA AVENUE
FREMONT AVE.
MATCH LINE
11+50 MEET EXIST. END AC OVERLAY & AC COLD MILLING
PCC D/W APPROACH
E.B.R. STA. 84+03.62, 83.30' LT. OF SURVEY ℄ = B4+03.70, 83' LT OF CONST. ℄ = END AC BERM & AC OVERLAY ℄ = 9+48 COLUMBUS AVE.
BEGIN PCC CURB REMOVAL
REMOVE PCC CURB
B.B.R. 10+86.84 BEGIN AC BERM @ 1.5' RT
BCR 10+00 END AC COLD MILLING
REMOVE CMP INLET
LATERAL "D" (SEE SHT. 14)
REMOVE AC BERM
CONST. 3" THICK AC SWALE
TRIM ROW OF OLEANDER
83+30.10 B.C. ℄ SURVEY
84+00. 59' LT. ℄ JURUPA AVE.
SLOPE VARIES 4:1 TO 1:1
R=1200' (℄ ULT. IMP.)
R=1313.57' (℄ SURVEY)
N58°12'19"E
GRADE BREAK LINE
6' R.O.E.
JURUPA AVE. ℄ SURVEY = ℄ CONST.
EXIST IMP. PER R-2850
STA. 83+00
B.C. ULT. IMP. 83+38.26 ℄ CONSTRUCTION
6110
6111
6127
6091
6087-9
6086
6010
84+76.44 E.C. ℄ SURVEY=84+76.49 ℄ ULT. IMP.
JURUPA AVE. = 10+00 FREMONT AVE.
JURUPA AVE. 84+73.11 ℄ SURVEY B.C.
FREMONT AVE. =9+92.25 SURVEY B.C.
LATERAL "E" (SEE SHT. 14)
BEGIN AC BERM 9+25
9+15 MEET EXIST
PROVIDE 10' OPENING
END AC COLD MILLING
8+83 BEGIN AC OVERLAY
FUTURE CURB LINE
REMOVE PCC CURB
BEGIN PCC CURB REMOVAL
RELOCATE R-1
REMOVE EXIST. CMP INLET & INSTALL TIMBER BULKHEAD
B.B.R. 9+52.23 @ 1.5' RT.
E.B.R. 84+95.67, 31' RT. OF CONST. ℄ = 84+95.79, 23.39' RT. OF SURVEY ℄
E.B.R. 84+95.79, 37.69' LT. OF SURVEY ℄ = 85+49.29, 69' LT. OF CONST. ℄
CONSTRUCT 3" THICK AC SWALE
EXIST. 39" SD PER D-410
EXIST. 27" SD PER D-410
EXIST. 24" SD PER D-410
EXIST. 18" SD PER D-410
EXIST. 6"W
EXIST. 12"W
EXIST. 8"W
EXIST. 4"G
EXIST. 3"G
EXIST. 12"S
EXIST. 8"S
EXIST. 6"S
EXIST. 3"S

CONSTRUCTION NOTE:

1. CONSTRUCT STAMPED CONCRETE IN MEDIAN ISLAND. COLOR SHALL BE LA CRESENTA BROWN, A-25. USE RUNNING BOND COBBLE STONE PATTERN.
7. SAWCUT 5' CURB & GUTTER AT WEAKEND PLANE JOINTS (10' INTERVALS) THROUGHOUT THE LENGTH OF CURB. NO HAND TOOLS SHALL BE USED AT ALL JOINTS.

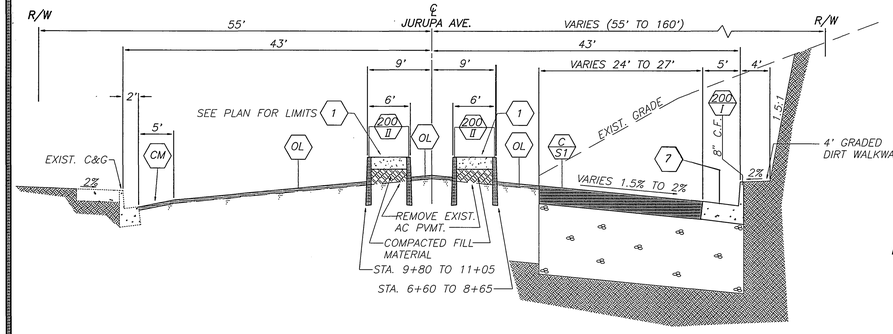

RT. STA. 8+35.83
TO STA. 15+22.19

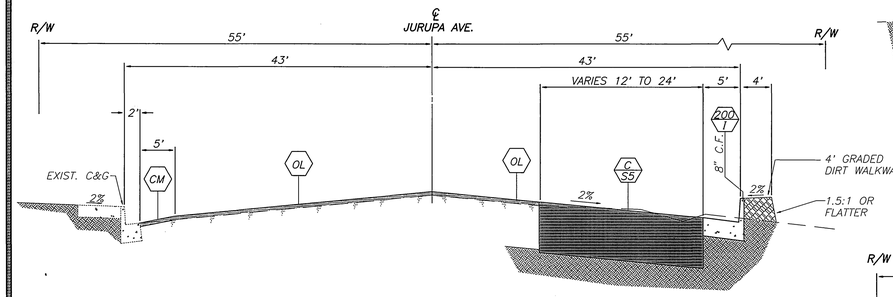

RT. STA. 15+22.19
TO STA. 18+92.50

RT. STA. 18+92.50
TO STA. 24+50

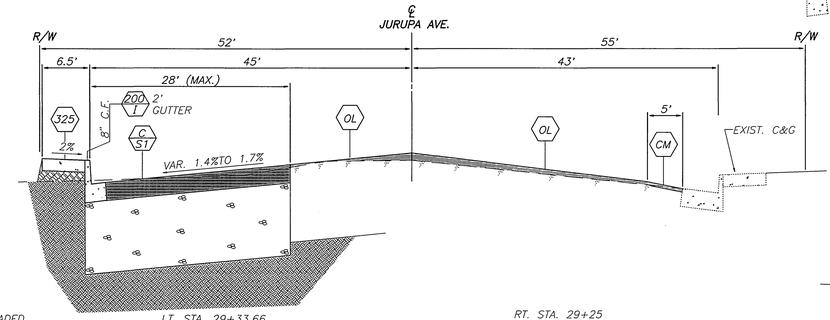

LT. STA. 29+33.66
TO STA. 30+53

RT. STA. 29+25
TO STA. 36+00

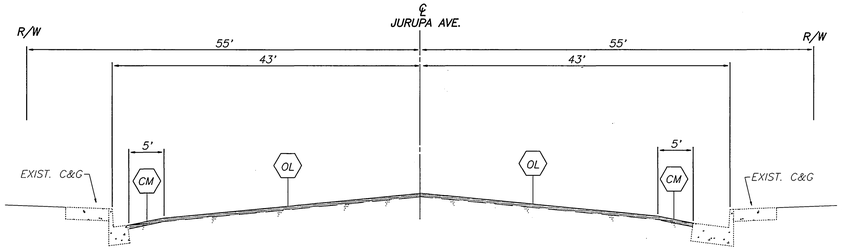

LT. STA. 30+53
TO STA. 34+70

RT. STA. 36+00
TO STA. 40+00

LT. STA. 35+96.68
TO STA. 38+21.50

RT. STA. 40+00
TO STA. 44+50

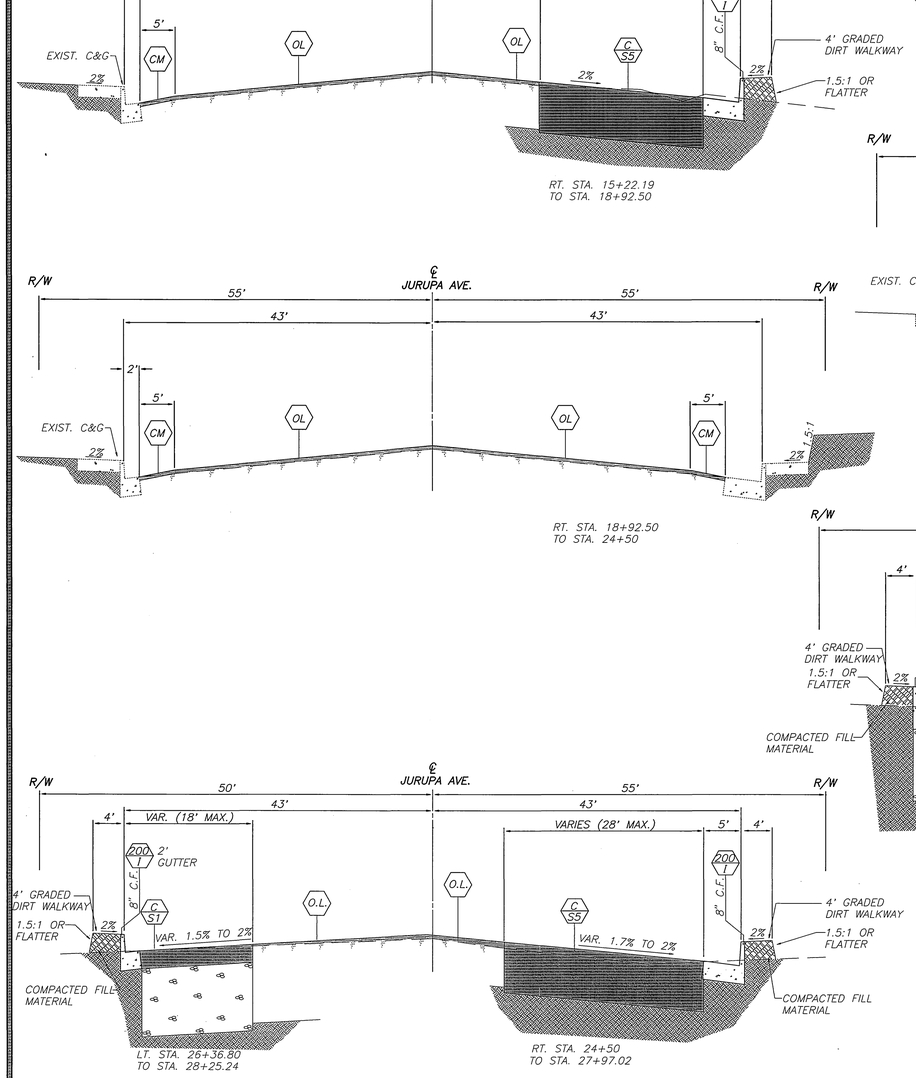

LT. STA. 26+36.80
TO STA. 28+25.24

RT. STA. 24+50
TO STA. 27+97.02

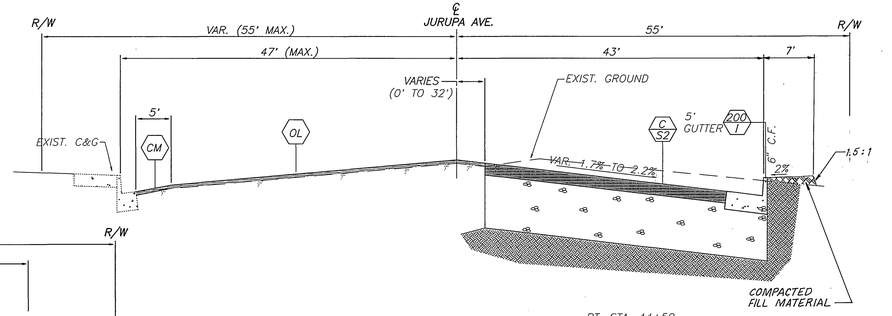

RT. STA. 44+50
TO STA. 49+36.01

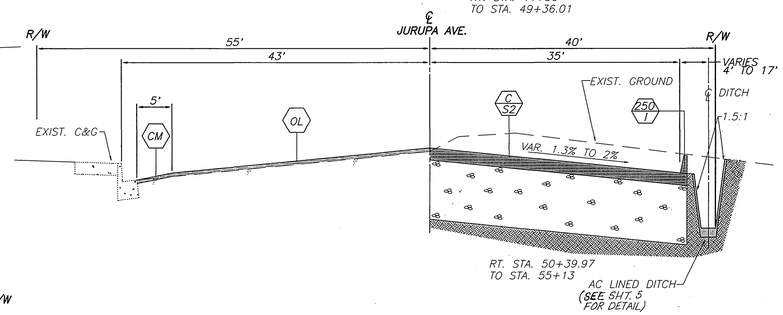

RT. STA. 50+39.97
TO STA. 55+13

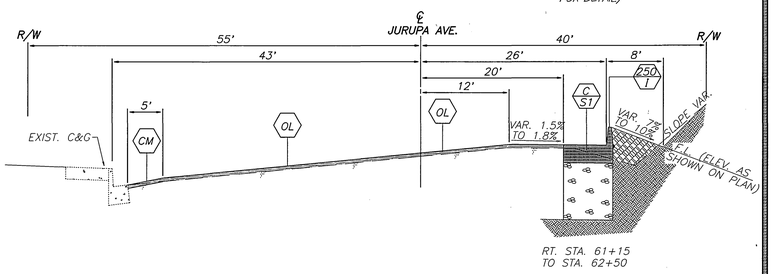

RT. STA. 61+15
TO STA. 62+50

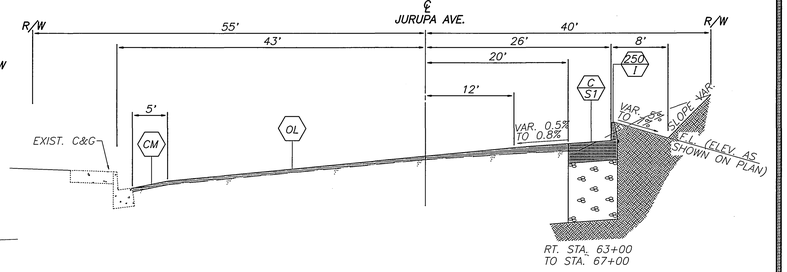

RT. STA. 63+00
TO STA. 67+00

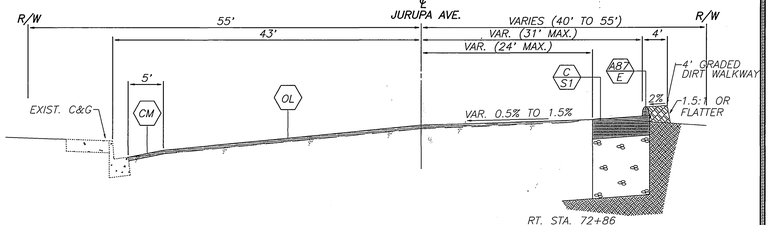

RT. STA. 72+86
TO STA. 79+95.89

✳ AS-BUILT 10-11-95 LH

REGISTERED PROFESSIONAL ENGINEER
DUANE K. GREENWOOD
No. 43965
Exp. 6/30/97
CIVIL
STATE OF CALIFORNIA

ENGINEER IN RESPONSIBLE CHARGE
DUANE K. GREENWOOD
R.C.E. No. 43965 expires 6/30/97
DATE 1/9/95

MARK	REVISIONS	APPR.	DATE

DESIGNED BY ____ DRAWN BY LFH CHECKED BY DKG

CITY OF RIVERSIDE, CALIFORNIA
PUBLIC WORKS DEPARTMENT

APPROVED BY	BY	DATE
DEPUTY P.W. DIRECTOR	[illegible]	1/26/95
PRINCIPAL ENGINEER	[illegible]	1/10/95
CHIEF P.W. INSPECTOR	[illegible]	1-26-95
TRAFFIC DIVISION	[illegible]	1/13/95
SURVEYOR	[illegible]	1/24/95
STREET SERVICES	[illegible]	1-26-95
PARKS DEPARTMENT	[illegible]	1/24/95

APPROVED BY ____
PUBLIC WORKS DIRECTOR
DATE 1/26/95

JURUPA AVE. WIDENING TYPICAL SECTIONS

HORIZ. SCALE: 1" = 10' VERT. SCALE: 1" = 2'

ACCT. NO.: 432-541500-440302-30328

R-3291

SHEET 11 OF 14

PC 3502-S

INDEXED 3-23-95 LH

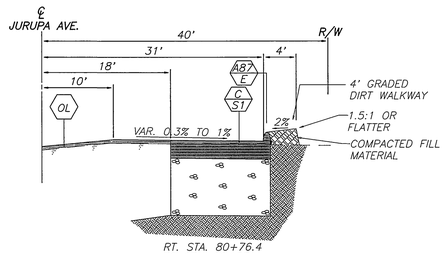

RT. STA. 80+76.4
TO STA. 82+37

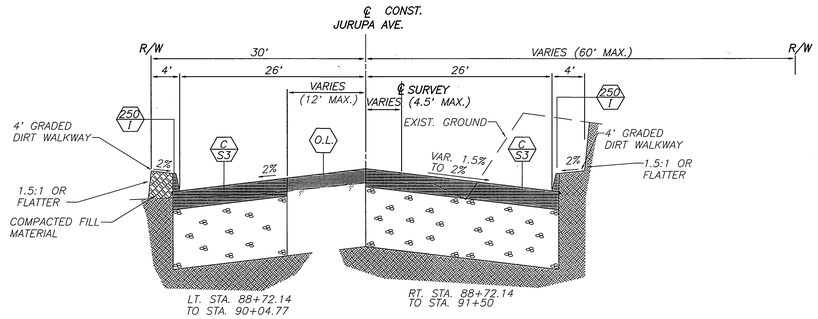

LT. STA. 88+72.14
TO STA. 90+04.77

RT. STA. 88+72.14
TO STA. 91+50

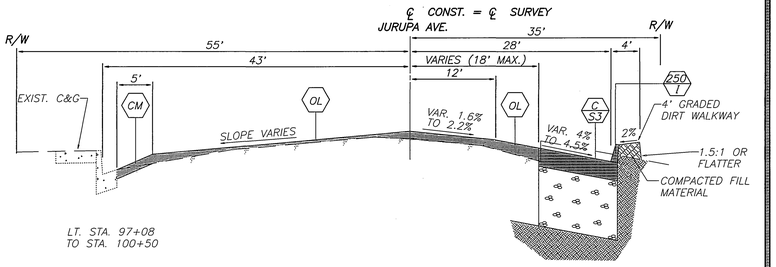

LT. STA. 97+08
TO STA. 100+50

RT. STA. 98+75
TO STA. 100+22.07

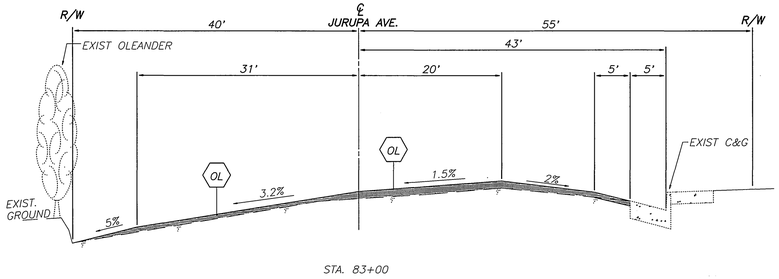

STA. 83+00

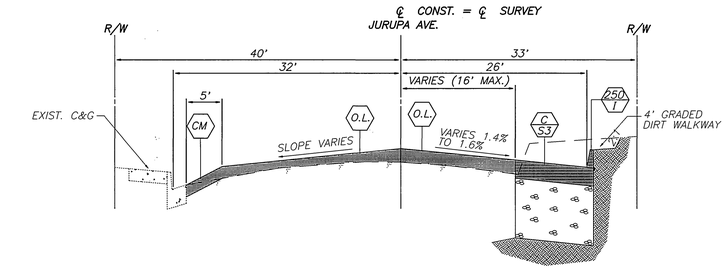

LT. STA. 91+00
TO STA. 94+04

RT. STA. 92+36.74
TO STA. 93+50

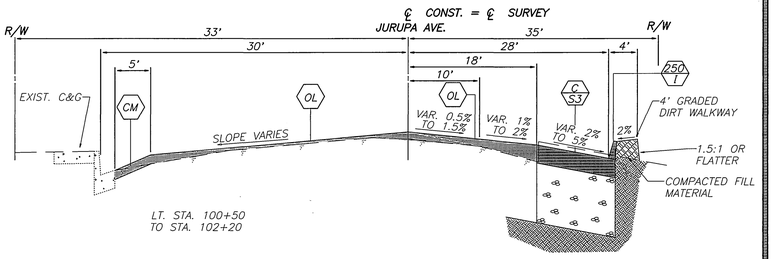

LT. STA. 100+50
TO STA. 102+20

RT. STA. 100+98.27
TO STA. 102+91.74

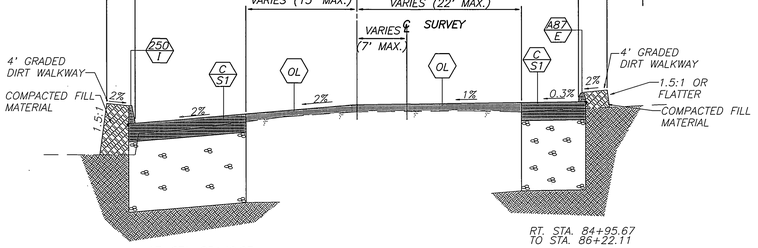

LT. STA. 85+49.27
TO STA. 86+22.11

RT. STA. 84+95.67
TO STA. 86+22.11

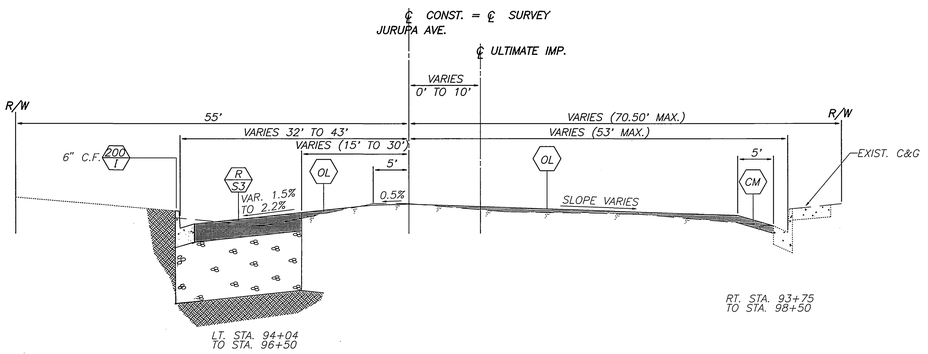

LT. STA. 94+04
TO STA. 96+50

RT. STA. 93+75
TO STA. 98+50

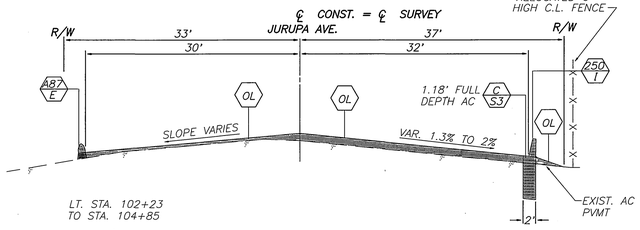

LT. STA. 102+23
TO STA. 104+85

RT. STA. 103+67.95
TO STA. 104+97.89

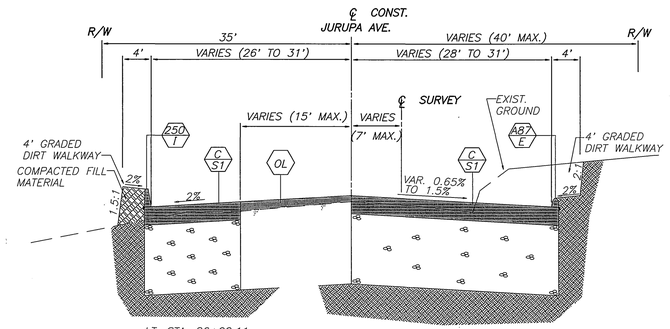

LT. STA. 86+22.11
TO STA. 88+72.14

RT. STA. 86+22.11
TO STA. 88+01.87

REGISTERED PROFESSIONAL ENGINEER
DUANE K. GREENWOOD
No. 43965
Exp. 6/30/97
CIVIL
STATE OF CALIFORNIA

ENGINEER IN RESPONSIBLE CHARGE
DUANE K. GREENWOOD
R.C.E. No. 43965 expires 6/30/97
DATE 1/9/95

MARK	REVISIONS	APPR.	DATE

DESIGNED BY DKG DRAWN BY LFH CHECKED BY DKG

CITY OF RIVERSIDE, CALIFORNIA
PUBLIC WORKS DEPARTMENT

APPROVED BY	BY	DATE
DEPUTY P.W. DIRECTOR	RAC	2/1/95
PRINCIPAL ENGINEER	DK	1/9/95
CHIEF P.W. INSPECTOR	CFD	1-12-95
TRAFFIC DIVISION	DK	1/13/95
SURVEYOR	MKO	1/24/95
STREET SERVICES	RC	1/24/95
PARKS DEPARTMENT	AM	1-25-95

APPROVED BY
PUBLIC WORKS DIRECTOR
DATE 1/26/95

JURUPA AVE. WIDENING TYPICAL SECTIONS

HORIZ. SCALE: 1" = 10' VERT. SCALE: 1" = 2'

ACCT. NO.: 432-541500-440302-30328

R-3291

SHEET 12 OF 14

PC 3502-S

* AS-BUILT 10-11-95 LFH

INDEXED 3-23-95 LFH

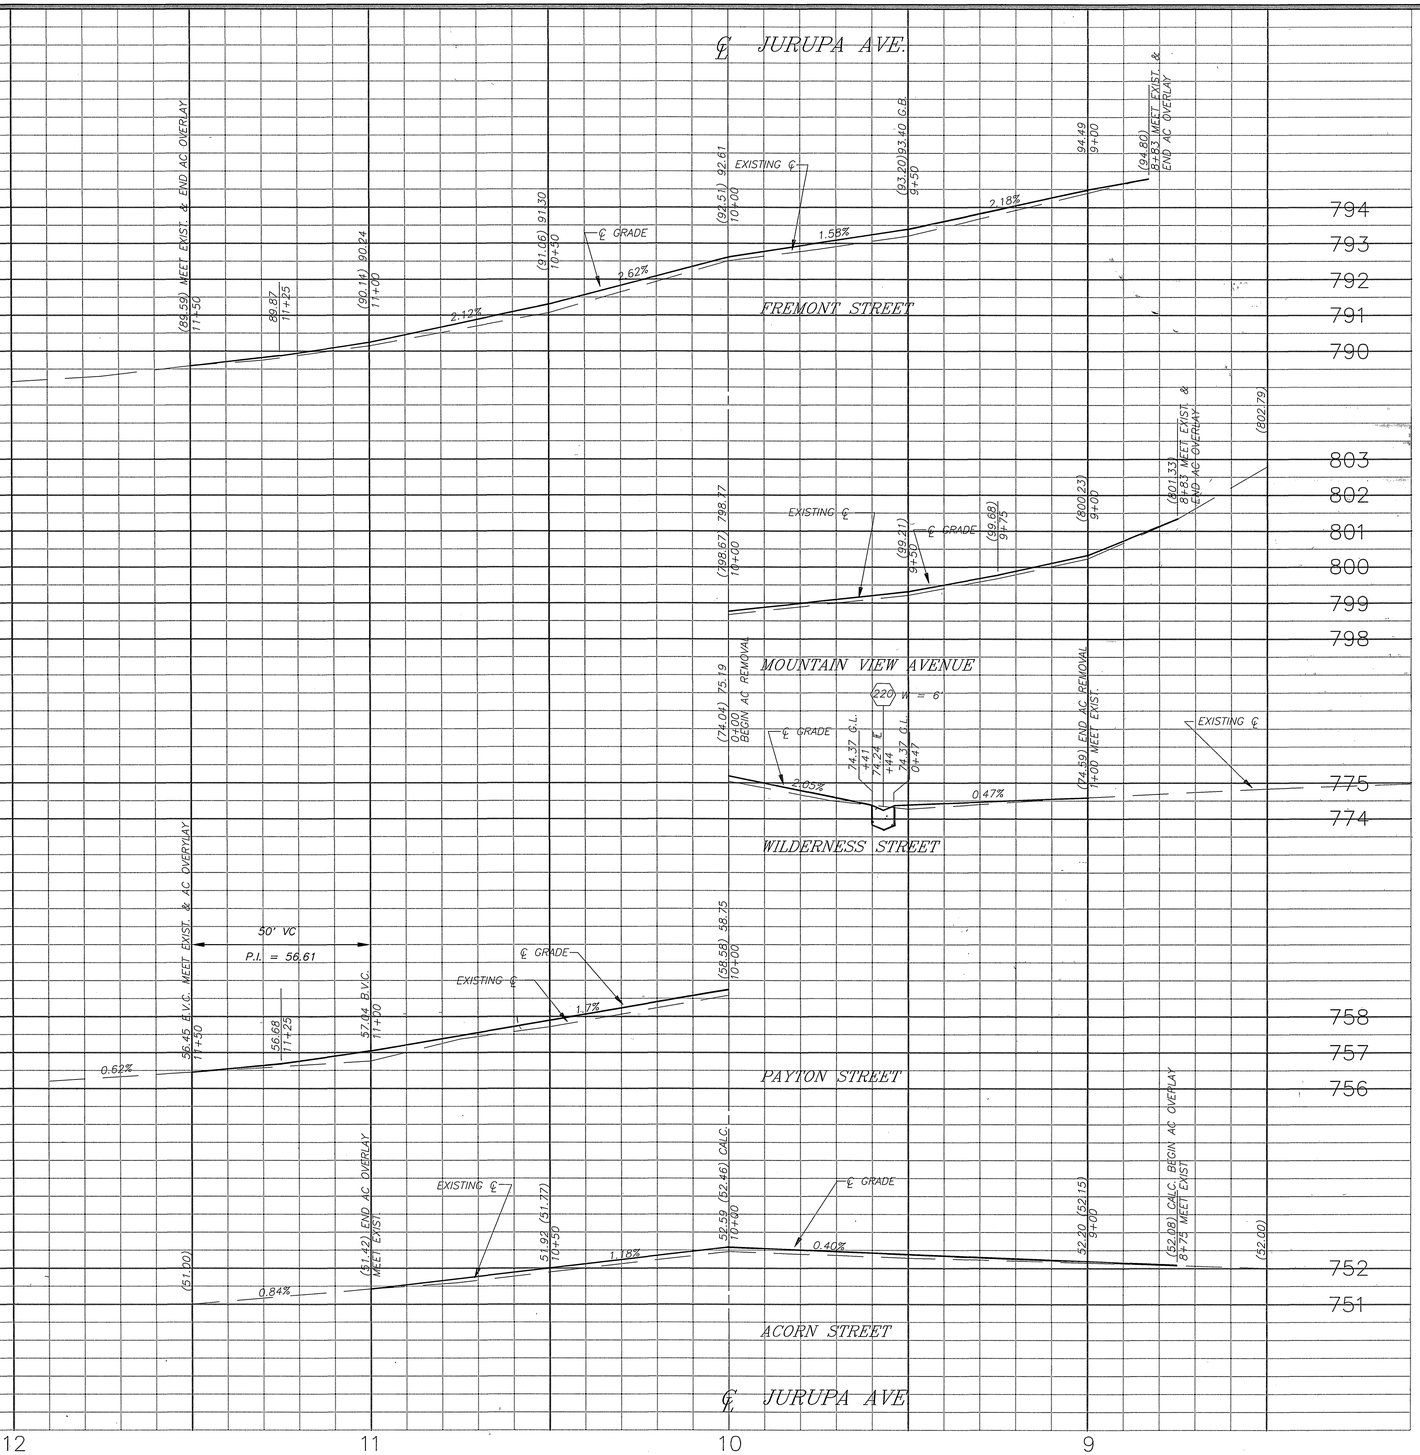

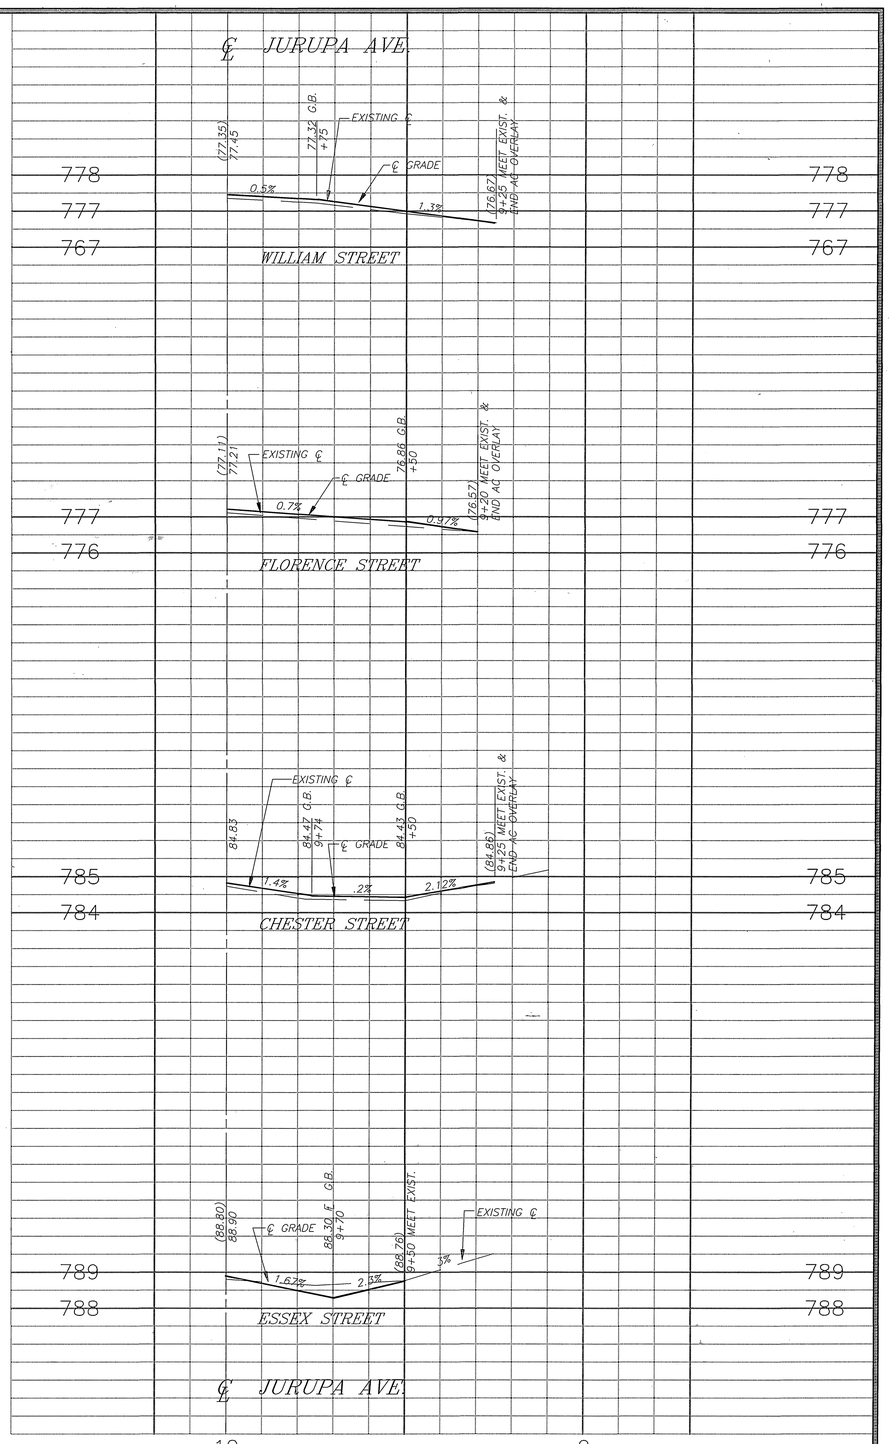

✳ AS-BUILT 10-11-95 LFH

REGISTERED PROFESSIONAL ENGINEER
DUANE K. GREENWOOD
No. 43965
Exp. 6/30/97
CIVIL
STATE OF CALIFORNIA

ENGINEER IN RESPONSIBLE CHARGE
DUANE K. GREENWOOD
R.C.E. No. 43065 expires 6/30/97
DATE 1/9/95

MARK	REVISIONS	APPR.	DATE

DESIGNED BY ____ DRAWN BY LFH CHECKED BY DKG

CITY OF RIVERSIDE, CALIFORNIA
PUBLIC WORKS DEPARTMENT

APPROVED BY	BY	DATE
DEPUTY P.W. DIRECTOR		7/11/95
PRINCIPAL ENGINEER		7/11/95
CHIEF P.W. INSPECTOR		7/12/95
TRAFFIC DIVISION		7/13/95
SURVEYOR		7/13/95
STREET SERVICES		7/20/95
PARKS DEPARTMENT		7/24/95

APPROVED BY
PUBLIC WORKS DIRECTOR
DATE 7/26/95

JURUPA AVE WIDENING PROFILE INTERSECTING STREETS

HORIZ. SCALE: 1" = 20' VERT. SCALE: 1" = 2'

ACCT. NO.: 432-541500-440302-30328

R-3291
SHEET 13 OF 14

PC 3502-S

INDEXED 3-23-95 LFH

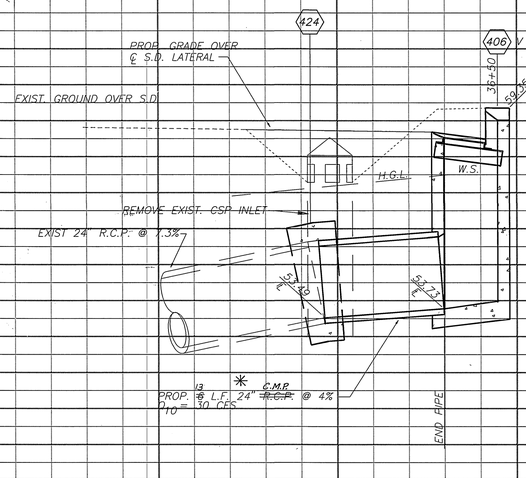

PROFILE LATERAL "C"

SCALE: HORIZ. 1" = 4', VERT. 1" = 2'

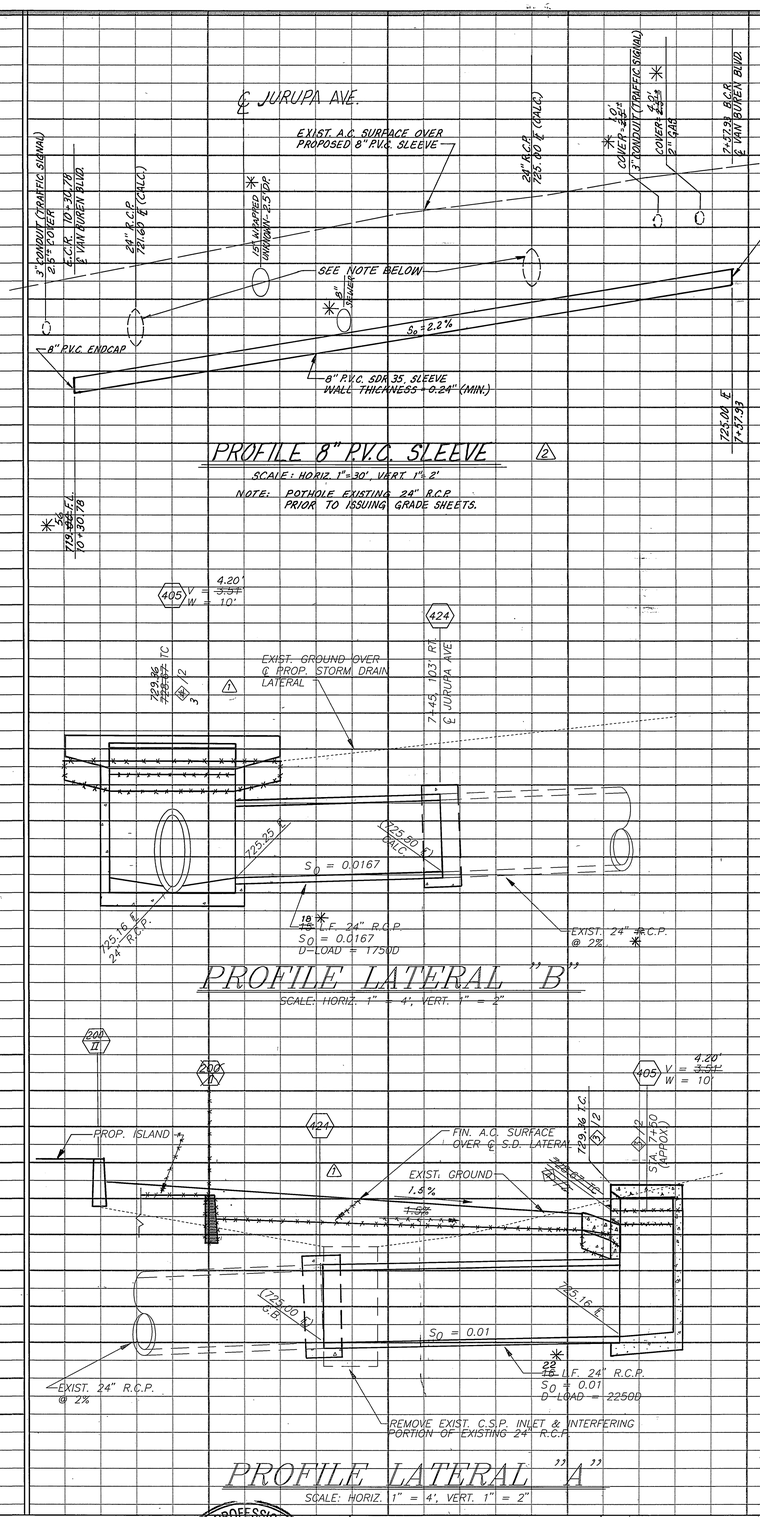

PROFILE 8" P.V.C. SLEEVE

SCALE: HORIZ. 1"=30', VERT. 1"=2'

NOTE: POTHOLE EXISTING 24" R.C.P. PRIOR TO ISSUING GRADE SHEETS.

PROFILE LATERAL "B"

SCALE: HORIZ. 1" = 4', VERT. 1" = 2"

PROFILE LATERAL "A"

SCALE: HORIZ. 1" = 4', VERT. 1" = 2"

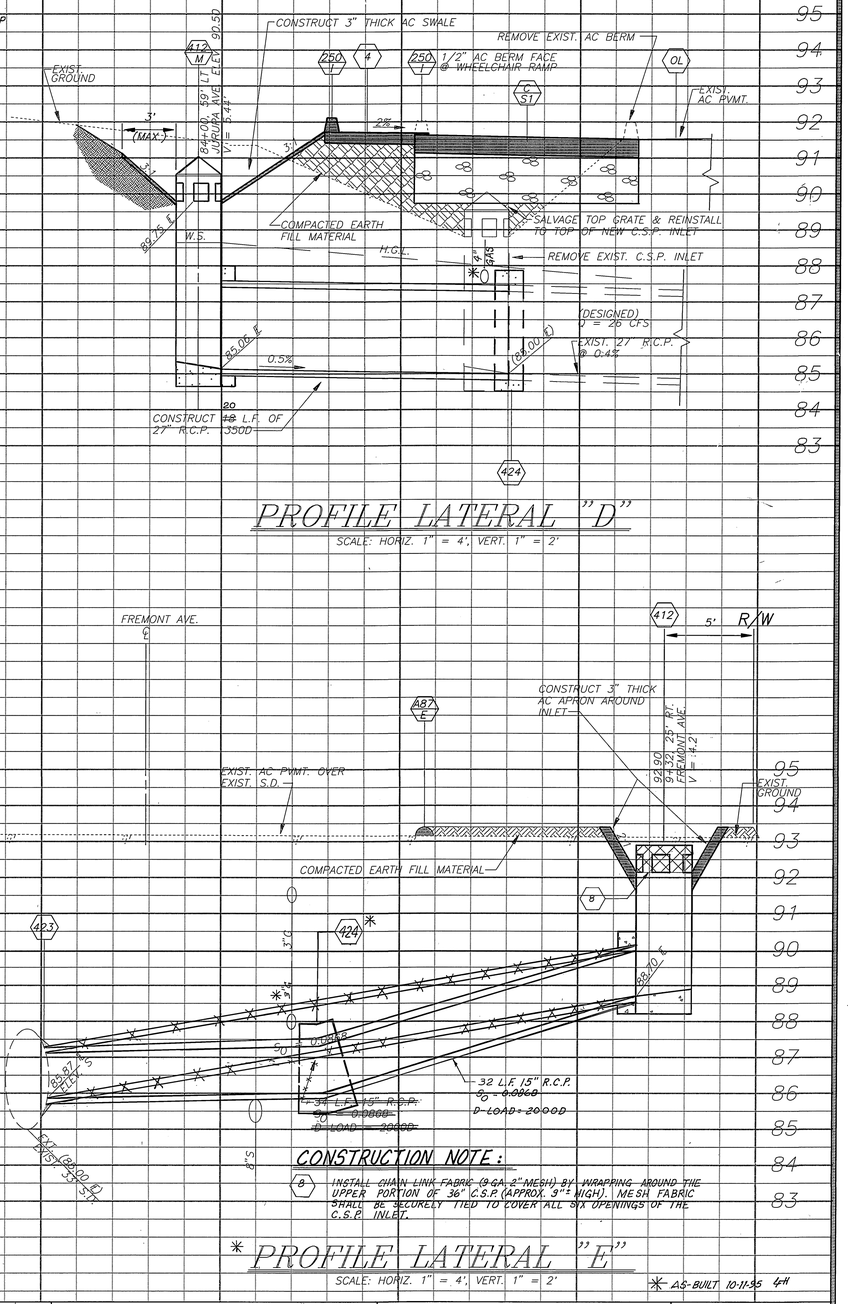

PROFILE LATERAL "D"

SCALE: HORIZ. 1" = 4', VERT. 1" = 2'

CONSTRUCTION NOTE:

8 INSTALL CHAIN LINK FABRIC (9 GA. 2" MESH) BY WRAPPING AROUND THE UPPER PORTION OF 36" C.S.P. (APPROX. 3'± HIGH). MESH FABRIC SHALL BE SECURELY TIED TO COVER ALL SIX OPENINGS OF THE C.S.P. INLET.

PROFILE LATERAL "E"

SCALE: HORIZ. 1" = 4', VERT. 1" = 2'

✳ AS-BUILT 10-11-95 LFH

REGISTERED PROFESSIONAL ENGINEER — DUANE K. GREENWOOD — No. 43965 — Exp. 6/30/97 — CIVIL — STATE OF CALIFORNIA

ENGINEER IN RESPONSIBLE CHARGE

DUANE K. GREENWOOD
R.C.E. No. 43965 expires 6/30/97

DATE 1/9/95

MARK	REVISIONS	APPR.	DATE
2	ADDED 8" P.V.C. SLEEVE	DKG	5/10/95
1	REVISED STORM DRAIN PROFILE LATERALS "A" "B"	DKG	5/10/95

DESIGNED BY DKG DRAWN BY LFH CHECKED BY DKG

CITY OF RIVERSIDE, CALIFORNIA
PUBLIC WORKS DEPARTMENT

APPROVED BY	BY	DATE
DEPUTY P.W. DIRECTOR	MLG	7/7/95
PRINCIPAL ENGINEER	DKG	11/7/95
CHIEF P.W. INSPECTOR	GR	12-28-95
TRAFFIC DIVISION	[illegible]	11/13/95
SURVEYOR	MCD	11-13-95
STREET SERVICES	RR	11/21/95
PARKS DEPARTMENT		

APPROVED BY [signature]
PUBLIC WORKS DIRECTOR
DATE 1/26/95

STORM DRAIN LATERAL PROFILE

HORIZ. SCALE: AS NOTED. VERT. SCALE: AS NOTED

ACCT. NO.: 432-541500-440302-30328

R-3291

SHEET 14 OF 14

PC 3502-S

INDEXED 3-23-95 LFH

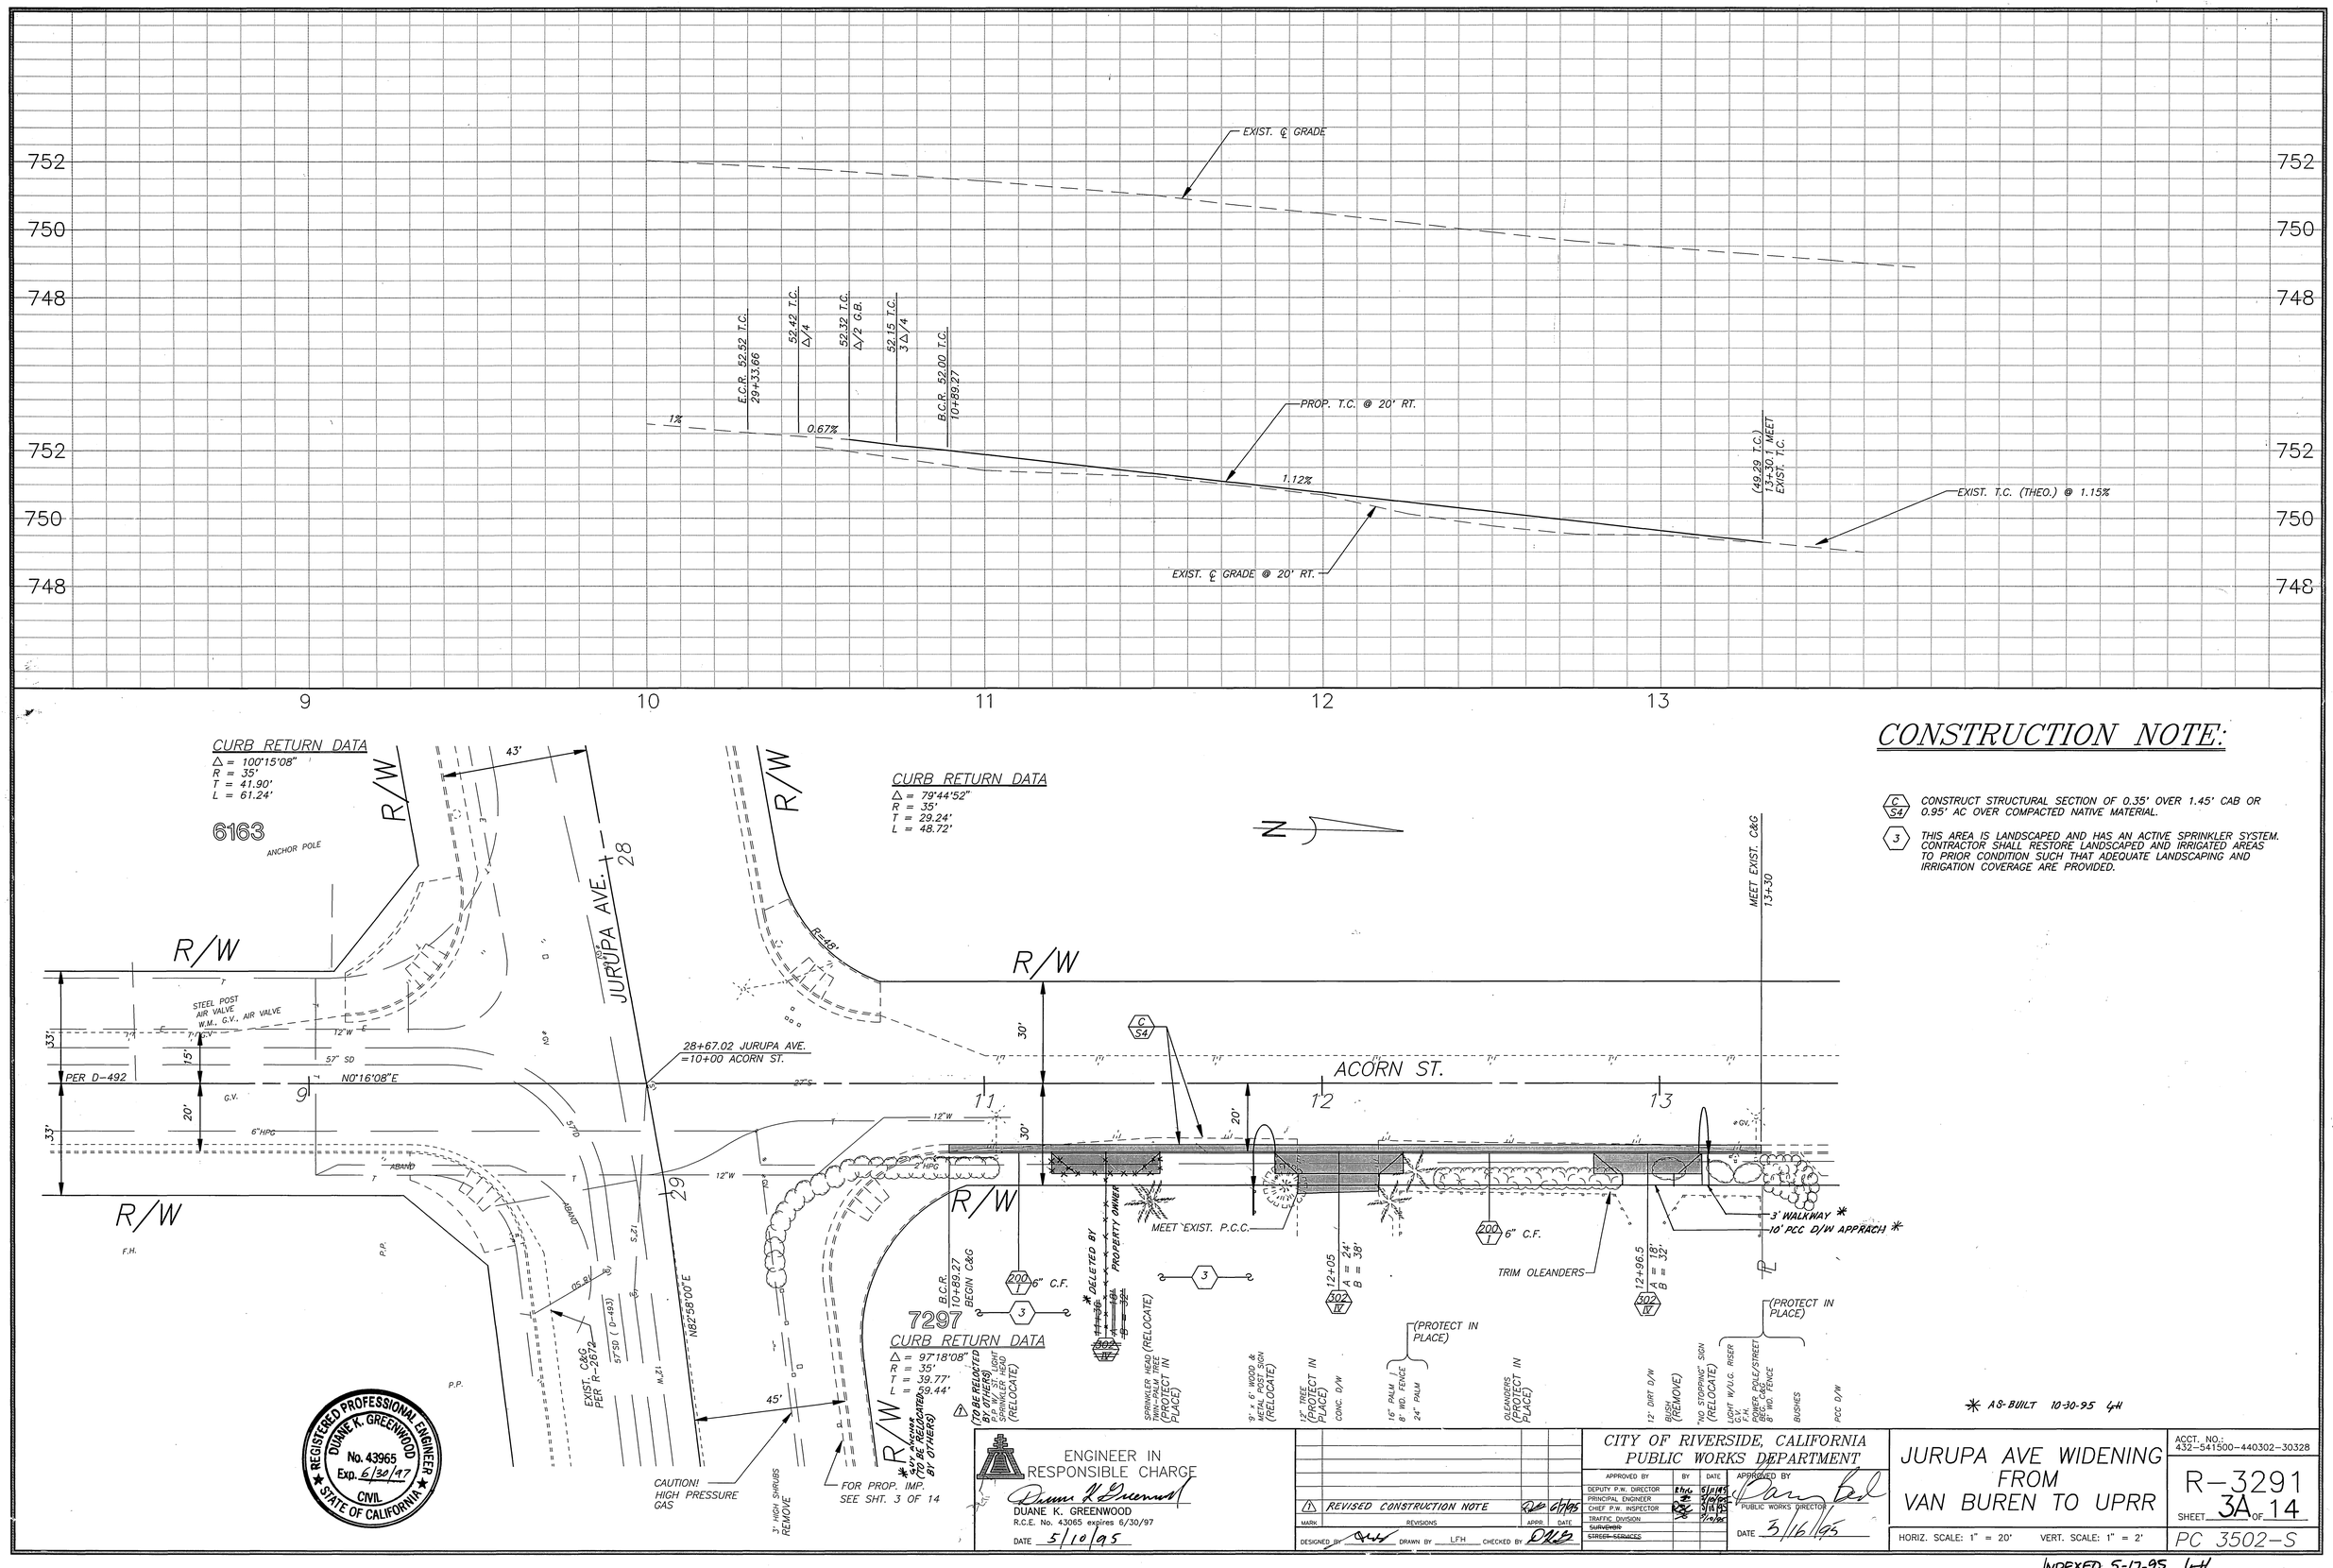

CONSTRUCTION NOTE:

C S4 — CONSTRUCT STRUCTURAL SECTION OF 0.35' OVER 1.45' CAB OR 0.95' AC OVER COMPACTED NATIVE MATERIAL.

3 — THIS AREA IS LANDSCAPED AND HAS AN ACTIVE SPRINKLER SYSTEM. CONTRACTOR SHALL RESTORE LANDSCAPED AND IRRIGATED AREAS TO PRIOR CONDITION SUCH THAT ADEQUATE LANDSCAPING AND IRRIGATION COVERAGE ARE PROVIDED.

* AS-BUILT 10-30-95 GH

REGISTERED PROFESSIONAL ENGINEER
DUANE K. GREENWOOD
No. 43965
Exp. 6/30/97
CIVIL
STATE OF CALIFORNIA

ENGINEER IN RESPONSIBLE CHARGE
Duane K Greenwood
DUANE K. GREENWOOD
R.C.E. No. 43065 expires 6/30/97
DATE 5/10/95

MARK	REVISIONS	APP'D	DATE
1	REVISED CONSTRUCTION NOTE	DKG	6/1/95

DESIGNED BY DKG DRAWN BY LFH CHECKED BY DKG

CITY OF RIVERSIDE, CALIFORNIA
PUBLIC WORKS DEPARTMENT

APPROVED BY	BY	DATE
DEPUTY P.W. DIRECTOR	[illegible]	6/1/95
PRINCIPAL ENGINEER	[illegible]	5/10/95
CHIEF P.W. INSPECTOR	[illegible]	5/11/95
TRAFFIC DIVISION		5/10/95
~~SURVEYOR~~		
~~STREET SERVICES~~		

APPROVED BY [signature]
PUBLIC WORKS DIRECTOR
DATE 3/16/95

JURUPA AVE WIDENING FROM VAN BUREN TO UPRR

ACCT. NO.: 432-541500-440302-30328

R-3291

SHEET 3A OF 14

HORIZ. SCALE: 1" = 20' VERT. SCALE: 1" = 2'

PC 3502-S

INDEXED 5-17-95 GH