


## SPECIFIC CONSTRUCTION NOTES

- (ADJ CO) ADJUST SEWER CLEAN OUT COVER AND FRAME TO THE FINISHED PAVEMENT GRADE.
- (OL AC) 0.1' (TYPICAL) DGAC OVERELAY ON EXISTING PAVEMENT.
- (P) PLANT 15 GALLON STREET TREE AS NOTED ON THE PLANS. TREE TO BE PLANTED AND PRECISELY LOCATED AS DIRECTED BY THE STREET TREE INSPECTOR AND AS DESCRIBED IN THE PARK AND RECREATION SECTION OF THE ACCOMPANYING SPECIAL PROVISIONS. THE DESIGNATED STREET TREE IS THE "EUCALYPTUS FICIFOLIA/RED FLOWERING GUM".
- (PCC CURB) CONSTRUCT VARIABLE HEIGHT PCC RETAINING CURB.
- (R I) REMOVE EXISTING TREE. CLASS I–6" TO 18", CLASS II–OVER 18" TO 36", CLASS III–OVER 36".
- (REL F) RELOCATE CHAIN LINK FENCE TO 0.5' OUTSIDE R/W. (NOTE: REUSE EXISTING FENCE FABRIC AND USE NEW IN KIND POSTS)
- (R&R S) REMOVE EXISTING AC PAVEMENT AND REPLACE WITH 6" DGAC OVER COMPACTED SOIL.
- (T) TRANSPLANT EXISTING PALM TREE, AS DIRECTED BY STREET TREE INSPECTOR AND AS DESCRIBED IN PARK & RECREATION SECTION OF THE ACCOMPANYING SPECIAL PROVISIONS. LOCATION TO BE DETERMINED BY THE STREET TREE INSPECTOR (TREE SIZE SHOWN ON PLANS).
- (S/W 1%) CONSTRUCT 1% CROSS SLOPE SIDEWALK AND PARKWAY FROM CURB FACE TO BACK OF SIDEWALK BET. STA. 16+00 AND 16+25 TO ALLOW SURFACE DRAIN FROM BACK OF SIDEWALK.

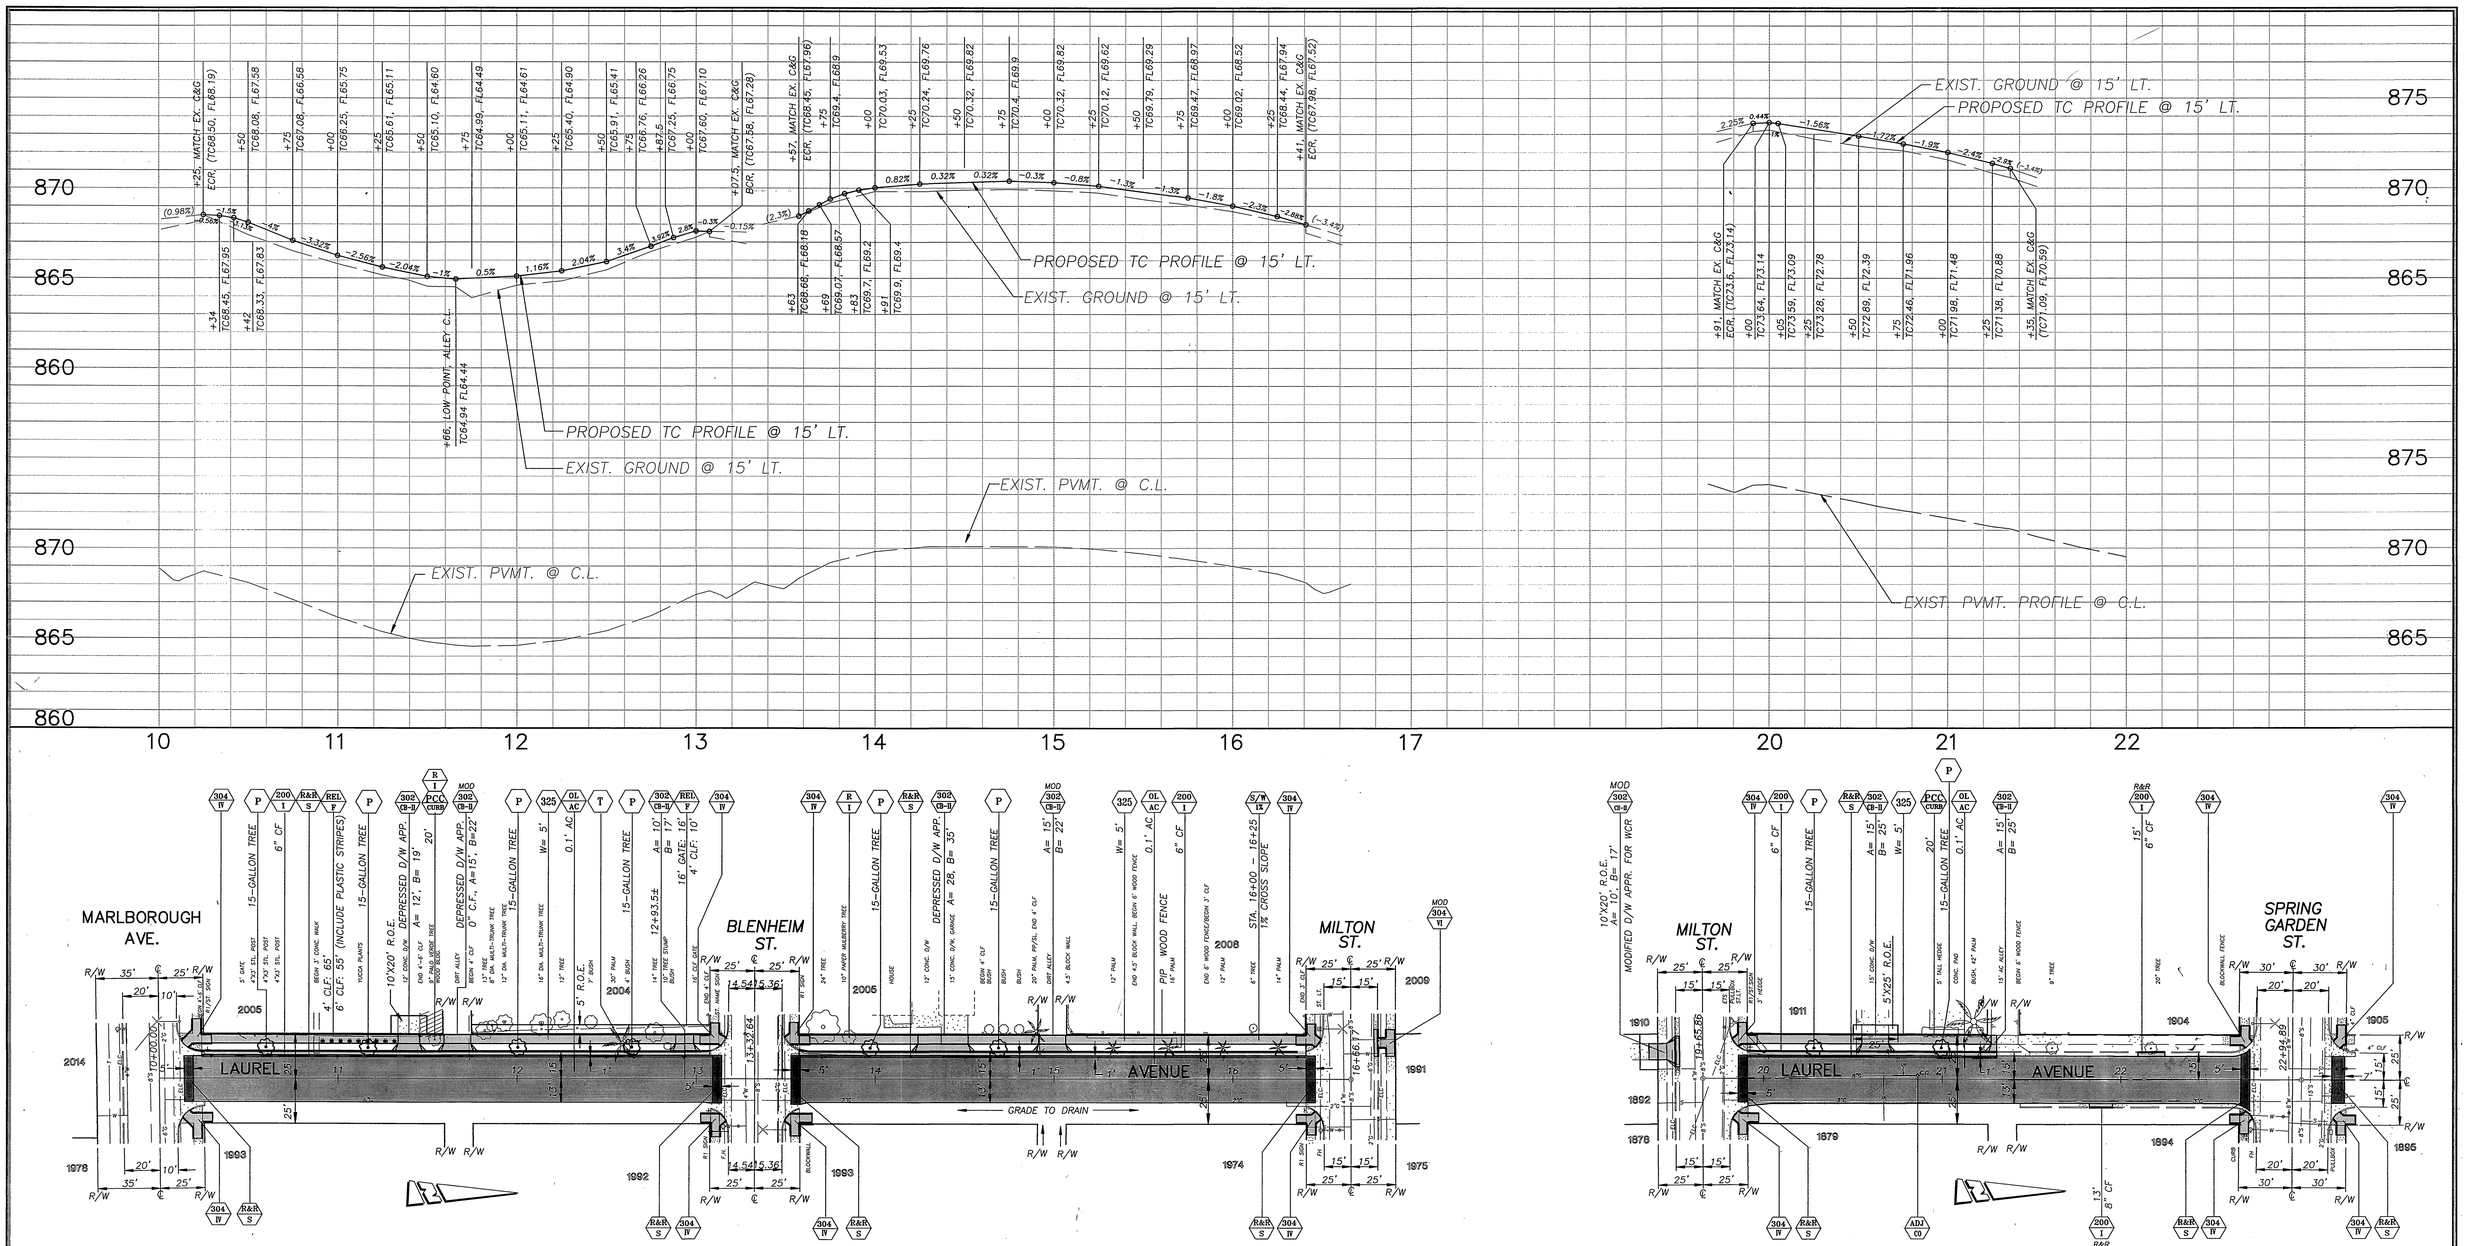


LAUREL AVE. TYPICAL SECTION

SCALE: HOR. 1" = 10' VER. 1" = 2'

FB : LL45/58

EL : 868.272

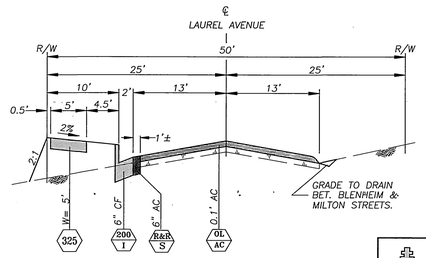BM : PK & TAG IN ST. LT. BASE AT NW CURB RETURN OF LAUREL AVE. AT MARLBOROUGH AVE.

*AS-BUILT 8-18-03 4H

ENGINEER IN RESPONSIBLE CHARGE

LAUREN F. CALDWELL
R.C.E. No. 39441 expires 12/31/2001
DATE 4/12/99

REGISTERED PROFESSIONAL ENGINEER LAUREN F. CALDWELL No. 39441 Exp. 12-31-2001 CIVIL STATE OF CALIFORNIA

| MARK | REVISIONS | APPR. | DATE |
|---|---|---|---|

DESIGNED BY FYL DRAWN BY RJM FYL CHECKED BY

CITY OF RIVERSIDE, CALIFORNIA
PUBLIC WORKS DEPARTMENT

| APPROVED BY | BY | DATE |
|---|---|---|
| ENGINEERING MANAGER | TFB | 4/13/99 |
| PRINCIPAL ENGINEER | [illegible] | 4/12/99 |
| STREET SERVICES | [illegible] | 4/25/99 |
| SURVEYOR | MSB | 3/22/99 |
| TRAFFIC DIVISION | [illegible] | 3/19/99 |
| PARKS DEPARTMENT | PKT | 3/22/99 |

APPROVED BY Rick. McGrath
PUBLIC WORKS DIRECTOR
DATE 4-12-99

STREET IMPROVEMENTS (CDBG 1997/98)

LAUREL AVENUE (MARLBOROUGH TO SPRING GARDEN)

HORIZ. SCALE: 1" = 40' VERT. SCALE: 1" = 4'

ACCT. NO. 220-528200-440120-12113

R-3487A

SHEET 1 OF 1

FILE: MDICK\DWG\R3487a
PARK & REC.: PC-4104-S/P

INDEXED 4-19-99 4H