AS BUILT DRAWINGS

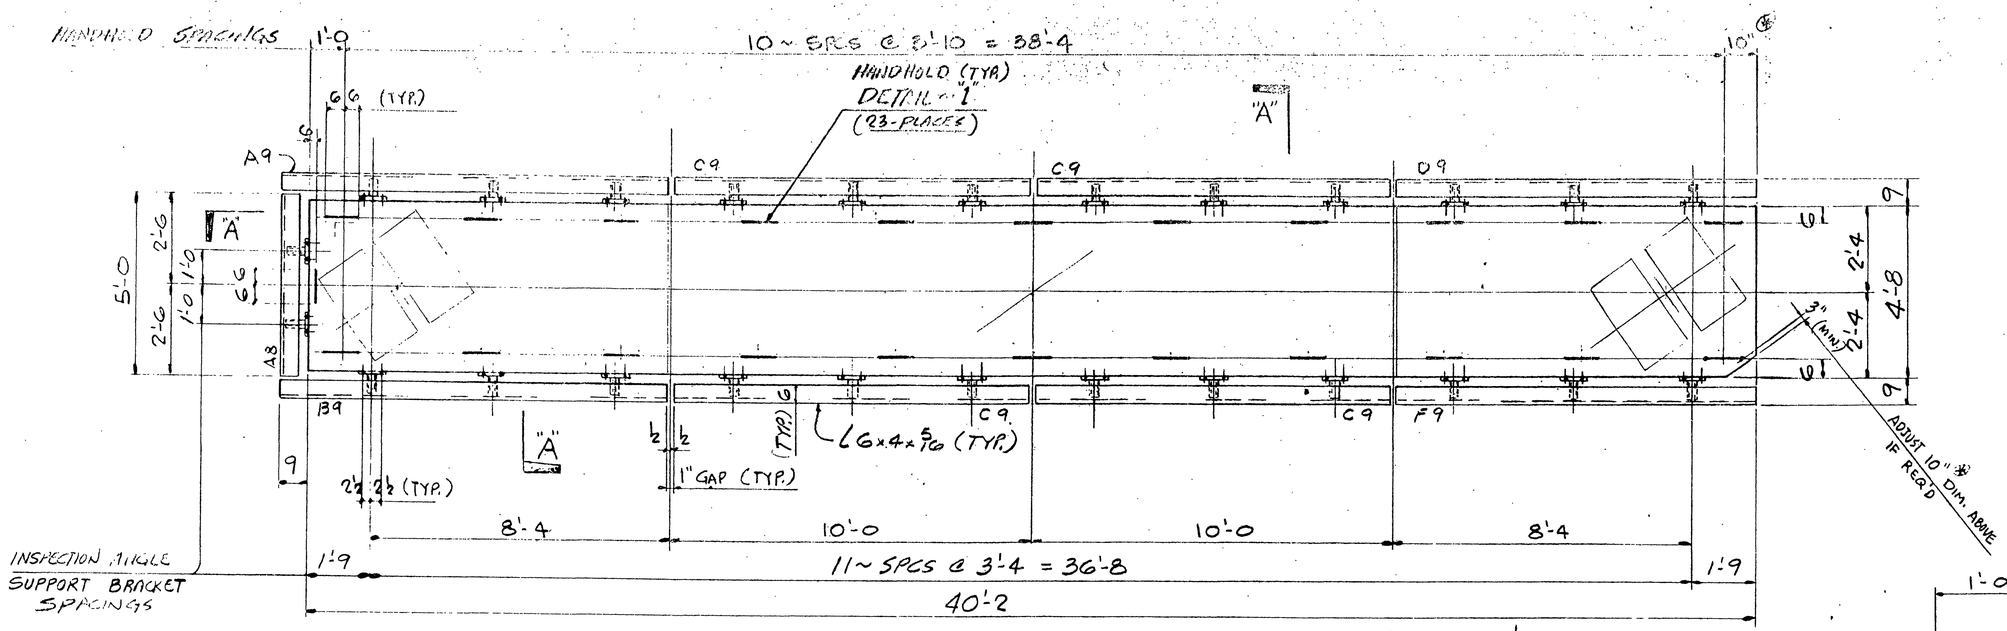

INSPECTION FACILITIES PLAN

NORTH

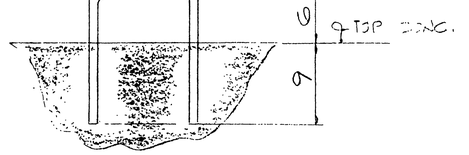

DETAIL ~ "1"
(23-PLACES)

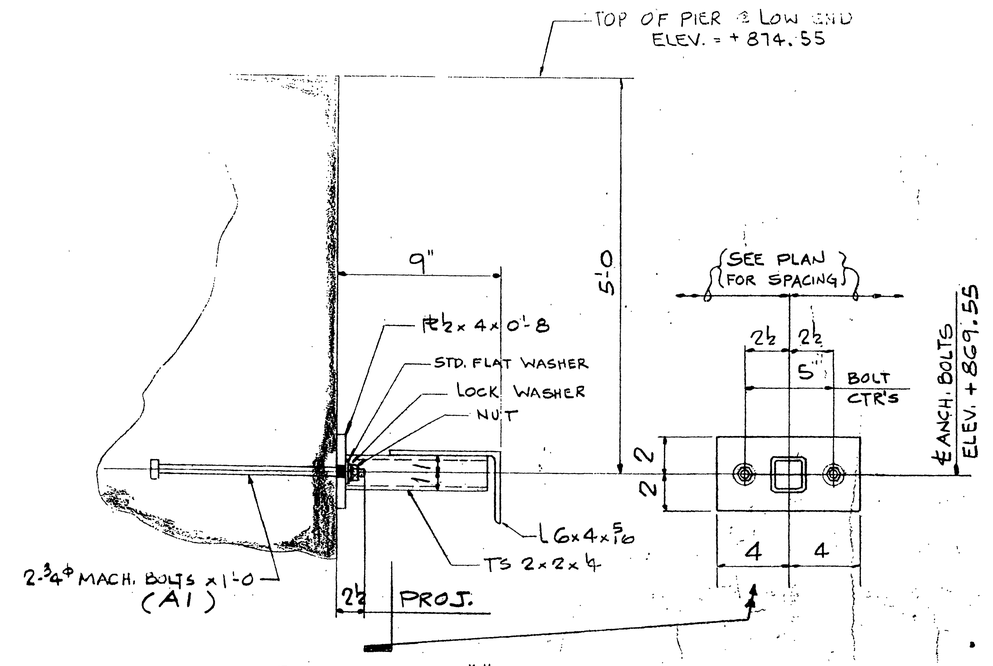

SECTION ~ "A"

NOTE:
ALL MATERIAL THIS SHEET TO BE GALVANIZED.

NO.	BY	DATE	DESCRIPTION
			REVISIONS

HOLES: UNLESS NOTED | REF:
SURFACE PREP.
SHOP PAINT
DESCRIPTION: INSPECTION FACILITIES PLAN & DETAILS
STRUCTURE: A.T.&S.F. CENTRAL AVE UNDERPASS; BRIDGE 11.82
PROJECT: 06791 SOUTHERN CA. COMMUTER PROJECT
LOCATION: RIVERSIDE, CA.
CUSTOMER: ATCHISON, TOPEKA & SANTA FE RAILWAY
ARCHITECT: HDR ENGINEERING, INC.

Grand Junction Steel
GRAND JUNCTION, COLORADO R-3595

DRAWN BY: AFD	DATE: 3-95	W.O. 10082	
CHECKED BY: IRA	DATE: 3-95	SHEET NO. E1	REV.
APPROVED BY:	DATE:		

INDEXED 8-8-2000 GH

BRUNING 40-21 67275-J

AS BUILT DRAWINGS

87'-2
89'-0 ℄ GIRDER
87'-6 ℄ BRG.
28 - SPCS @ 2'-3 = 63'-0
4 - SPCS @ 2'-3 = 9'-0
4½ ℄ BRG.
10½
1'-½
℄ GDR.
SHOP BOLTED
INTERMEDIATE STIFF. L (SEE PLAN)
FIELD BOLTS (SEE SCHEDULE)
L W/GDR
LOOSE CONN. L - MK - C6
℄ W18

DETAIL - "1"

INDICATE LOCATION OF INTERMEDIATE STIFFENERS
℄ BM. (TYP.)
INDICATES LOCATION OF ½" ℄ BRACKETS
DETAIL-"1" THIS SHEET
GIRDER - 2B
GIRDER - 1A
2'-6 2'-0 2'-6
1'-1½
℄ BRNG.
18'-10½
28'-1
14'-0½
C.B. STA. 624' 46.10
1'-0 1'-0
20'-6
10'-3
17'-4½
1'-2½
7½
℄ BM. W21x93
3½
C7 x 9.8 (TYP. LATERAL BRACE)
W16 x 50 (TYP. DIAPHRAGM)
FILL PL 2 EG 22 PLCS
W18x86 (TYP. CROSS BEAM)
W18x46 STOOL (TYP.)
DETAIL "1" THIS SHEET
GIRDER - 1B
12
36.13%
8¾
℄ BRNG.
87'-6 ℄ BRNG.
89'-0 ℄ GIRDER
89'-2
14'-0½
28'-1
14'-0½
NORTH

FRAMING PLAN (SPAN # 2)

NOTE: ALL BOLTS ARE ¾ A325 TYPE 3 } TYP. HEX HD. FIELD BOLT LIST FBL-1
WASHER & NUT PROVIDED W/ EACH BOLT.

CONNECTIONS			BOLT LIST DESCRIPTIONS					
NO. OF CONN'S	NO. BOLTS EA. CONN.	DESCRIPTION	TOTAL QTY.	DIAM.	LGTH	BOLT GRADE TYPE	WASHER TYPE	GRIP
36	19	BRACKET TO L8x4x½	684	¾	2¼	A325-3	3	1"
38	18	BRACKET TO W18x86	684	↑	2¾	↑	↑	1⅜
150	3	L8x4x⅜ (W18x86) TO W21x93	450		2¾			1½
150	6	W18x86 TO ℄	900		3⅛			2
10	10	W18x86 TO W21x93	200		3⅛			1⅞
2	10	W21x93 TO ℄ BRG PL	20		3½			2⅛
2	10	W21x93 TO 8" BRG PL	20		4			2⅝
150	2	L4x4x⅜ TO W16x50	318		2½			1⅜
2	8	W16x50 TO W18x86	16		2¼			⅜
77	8	do	616		2½			1¼
6	5	W18x86 TO BRG PL	30		3¼			2
118	4	W18x46 STOOL TO W18x86	472		2½			1⅜
16	9	C7 BRACE TO W18x86 @ ℄	144		2¾			1⅜
30	2	C7 BRACE @ 19.86	60	↓	3¼	↓	↓	1⅝
2	19	DIRT TO ℄ STIFF.	38	¾	3¼	A325-3	3	2
2	1	C7 BRACE TO W18	2	↑	2¾	↑	↑	1⅜
2	2	" " " "	↑	do	2¾	do	do	do

HOLES:	UNLESS NOTED	REF:	
SURFACE PREP.			
SHOP PAINT			
DESCRIPTION:	FRAMING PLAN (SPAN #2)		
STRUCTURE:	AT&SF CENTRAL AVE UNDERPASS BRIDGE 1482 ** PROJECT: 04781 SOUTHERN CA. COMMUTER PROJECT.		
LOCATION:	RIVERSIDE, CA.		
CUSTOMER:	ATCHISON, TOPEKA & SANTA FE RAILWAY		
ARCHITECT:	HDR ENGINEERING, INC.		

Grand Junction Steel
GRAND JUNCTION, COLORADO. R-3595

DRAWN BY: AFO	DATE: 3-95	W.O. 10082	
CHECKED BY: IRA	DATE: 3-95	SHEET NO. E2	REV.
APPROVED BY:	DATE:		

DESCRIPTION / DATE / BY / NO. — REVISIONS

APPROVED FOR FABRICATION

INDEXED 8-8-2000 GH

BRUNING 4021 67276

AS BUILT DRAWINGS

SEE DETAIL-1"/E2

℄ PIER

℄ BRNG.

GIRDER-1A

℄ BRNG.

AG END PLT. BM. W24×93

17'-4⅝"

34'-9¼"

17'-4⅝"

C7×9.8 (TYP. LATERAL BRACE)

W16×50 (TYP. DIAPHRAGM)

FILLET-E15 (38 PLACES)

10'-3

20'-6

10'-3

10'-1.5

7½" 1'-2¼

1'-7½" 10½

2'-0

GIRDER 1B ℄ BRNG.

GIRDER 2-2A

W18×86 (TYP CROSS BEAM) SEE DET. 1/E2

W18×46 STOOL (TYP)

INDICATES LOCATION OF ½ PL BRACKETS (TYP)

INDICATES LOCATION OF INTERMEDIATE STIFFENERS

℄ BM.

℄ BRNG.

12 / 36 / 136 / 8¾

12 / 36 / 136 / 8¾

2'-10 | 5-SPCS @ 2'-3 = 11'-3 | 1'-9½ | 1'-9½ | 5-SPCS @ 2'-3 = 11'-3 | 2'-10 | 2'-6 | 2'-6 | 2'-6 | 28-SPCS @ 2'-3 = 63'-0 | 2'-0 | 2'-6 | 4 SPCS @ 2'-3 = 9'-0 | 4'-2 | CROSS BEAM SPACING

14'-0½ | 13'-10½

28'-1

89'-0 % GIRDER

89'-2

NORTH

FRAMING PLAN (SPAN # 1)

HOLES	UNLESS NOTED	REF
SURFACE PREP		
SHOP PAINT		
DESCRIPTION	FRAMING PLAN (SPAN # 1)	
STRUCTURE	A.T.&S.F. CENTRAL AVE. UNDERPASS BRIDGE 11.62	
	PROJECT WITH SOUTHERN CA. COMMUTER PROJECT	
LOCATION	RIVERSIDE, CA.	
CUSTOMER	ATCHISON TOPEKA & SANTA FE RAILWAY	
ARCHITECT	HDR ENGINEERING, INC.	

NO | BY | DATE | DESCRIPTION — REVISIONS

Grand Junction Steel
GRAND JUNCTION COLORADO R-3595

DRAWN BY: AFD.	DATE 3-95	W O 10082	
CHECKED BY: IRA	DATE 3-95	SHEET NO E8	REV
APPROVED BY	DATE		

INDEXED 8-8-2000 LH

BRUNING 40-21 67275

AS BUILT DRAWINGS

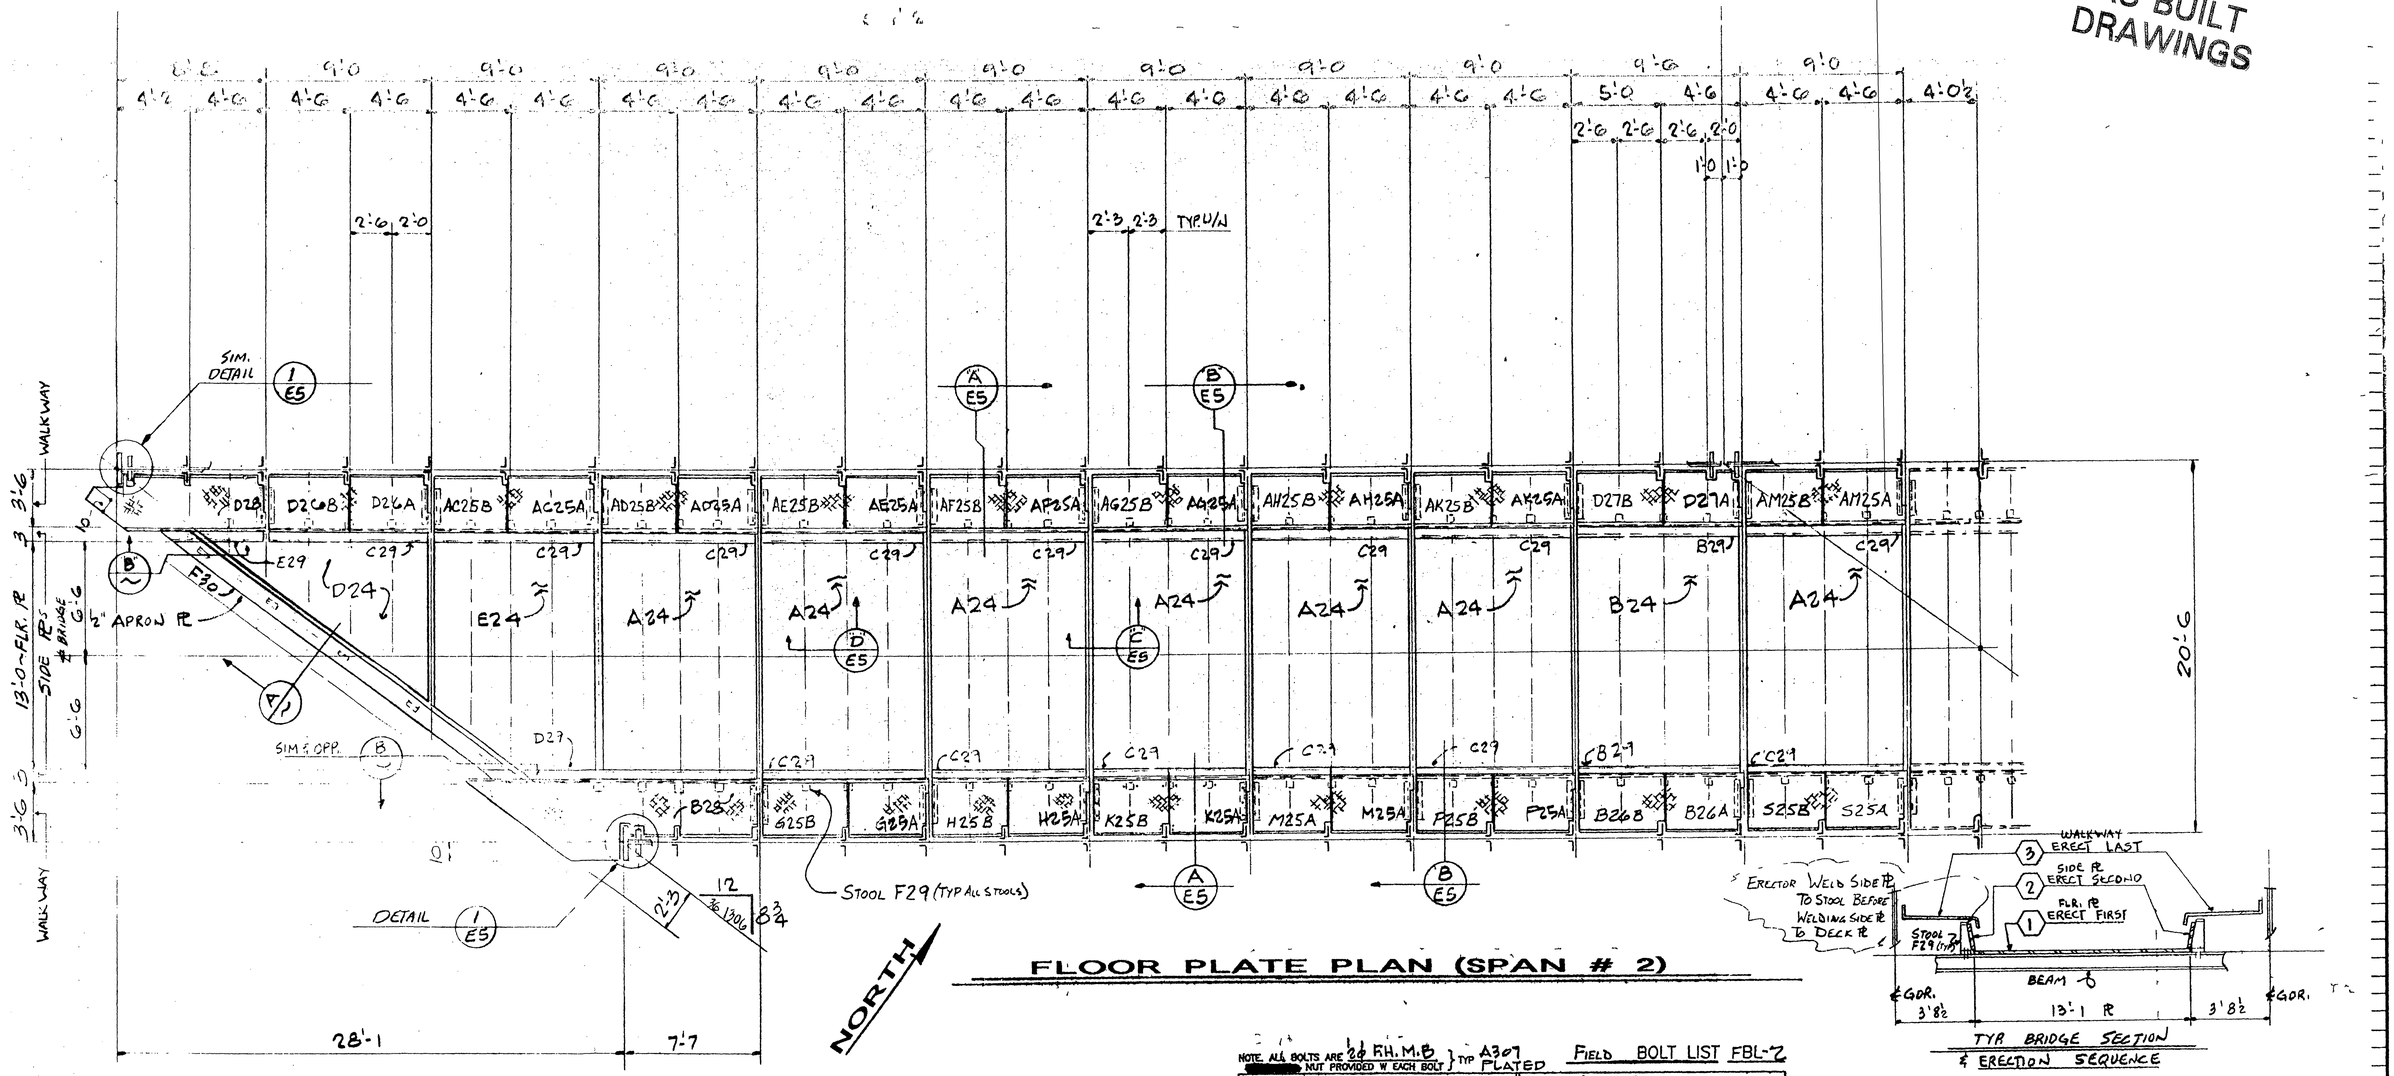

FLOOR PLATE PLAN (SPAN # 2)

TYP BRIDGE SECTION & ERECTION SEQUENCE

NOTE. ALL BOLTS ARE 24 F.H.M.B } TYP A307 PLATED NUT PROVIDED W EACH BOLT

FIELD BOLT LIST FBL-2

CONNECTIONS			BOLT LIST DESCRIPTIONS					
NO. OF CONNTS	NO BOLTS EA. CONN.	DESCRIPTION	TOTAL QTY	DIAM.	LGTH	BOLT GRADE TYPE	WASHER TYPE	GRIP
		CHKD PL To L	904	24	1½	A307	NONE	¾
		CHKD PL TO STOOLS	836	24	2¼	A307	NONE	1½

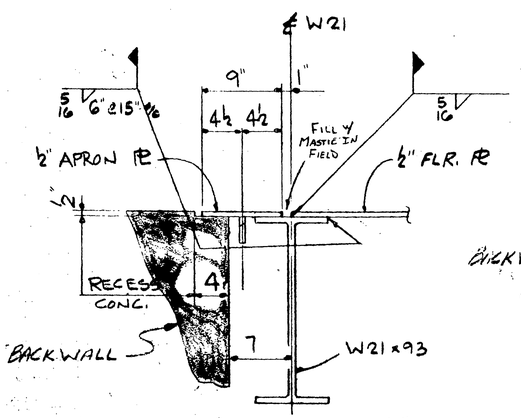

SECTION ~ "A"

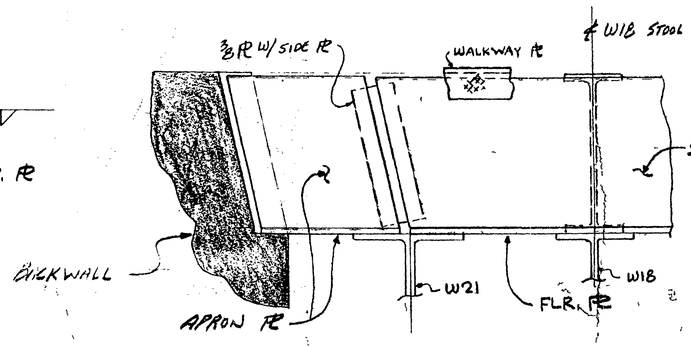

SECTION ~ "B"

INDEXED 8-8-2000 GH

NO	BY	DATE	DESCRIPTION
2	GB	5-10	ADD'D CHKD PLS & PL MK. (SEE SHT 2)
1	GB	5-23	ADD'D SIDE PL & BM STOOL

REVISIONS

HOLES	UNLESS NOTED REF
SURFACE PREP	
SHOP PAINT	
DESCRIPTION	FLOOR PLATE PLAN (SPAN # 2)
STRUCTURE	A.T.&S.F. CENTRAL AVE UNDERPASS, BRIDGE 11.82
	PROJECT: METRO SOUTHERN CA COMMUTER PROJECT
LOCATION	RIVERSIDE, CA.
CUSTOMER	ATCHISON, TOPEKA & SANTA FE RAILWAY
ARCHITECT	HDR ENGINEERING, INC

Grand Junction Steel
GRAND JUNCTION, COLORADO R-3595

DRAWN BY	AFD	DATE 4-95	WO 10082
CHECKED BY	ZRA	DATE 4-95	SHEET NO E4
APPROVED BY		DATE	REV 2

APPROVED FOR FABRICATION

AS BUILT DRAWINGS

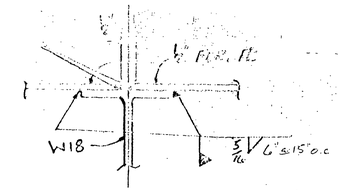

SECTION ~ "C"

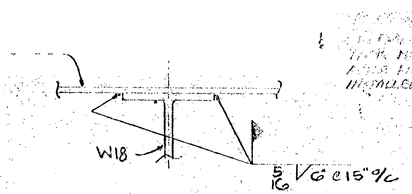

SECTION ~ "D"

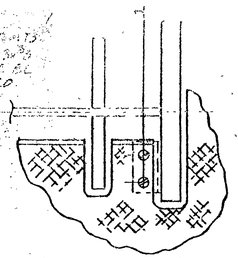

DETAIL ~ "1"

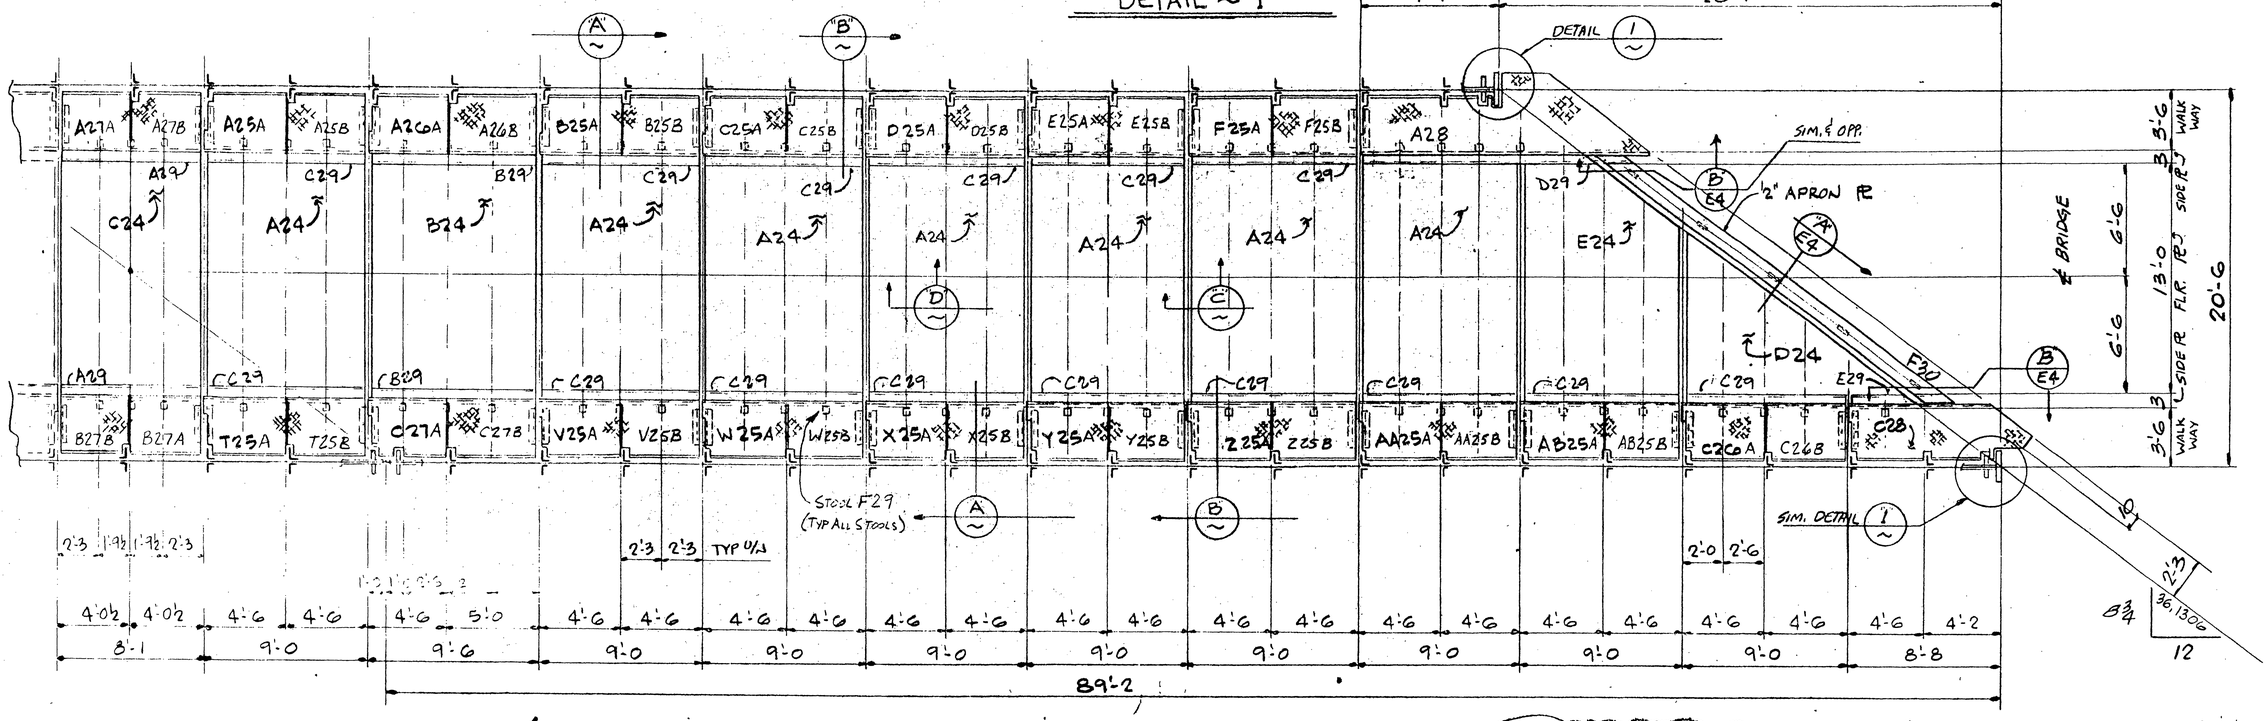

NORTH

FLOOR PLATE PLAN (SPAN # 1)

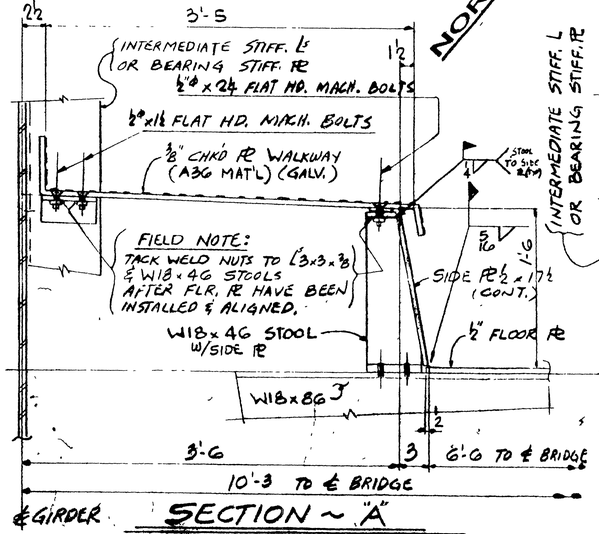

SECTION ~ "A"

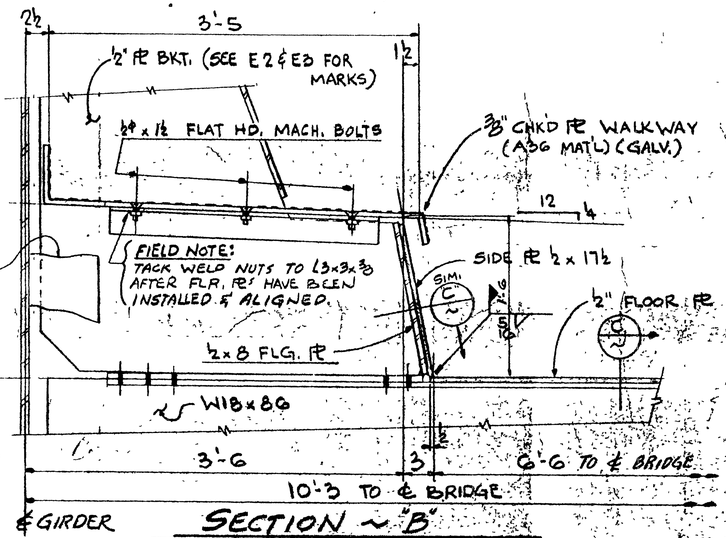

SECTION ~ "B"

ERECTOR NOTE:
SEE TYP. BRIDGE SECT. ON SHEET E4 FOR ERECTION SEQUENCE OF FLR. PL, SIDE PLS & WALKWAY.

INDEXED 8-8-2000 LH

NO	BY	DATE	REVISIONS
4	AFD	5-23	ADDED PLATE STOOLS AT ℄ BRG. REVISED DIM. AT ℄ BRG.
3	AFD	5-10	ADDED CHK. PL PL MARK EXCEPT <E5
2			
1			

HOLES UNLESS NOTED	REF
SURFACE PREP	
SHOP PAINT	
DESCRIPTION	FLOOR PLATE PLAN (SPAN #1)
STRUCTURE	A.T.&S.F. CENTRAL AVE UNDERPASS, BRIDGE 11.82
	PROJECT: 06791 SOUTHERN CA. COMMUTER PROJECT
LOCATION	RIVERSIDE, CA.
CUSTOMER	ATCHISON, TOPEKA & SANTA FE RAILWAY
ARCHITECT	HDR ENGINEERING, INC.

Grand Junction Steel
GRAND JUNCTION, COLORADO R-3595

DRAWN BY: AFD	DATE: 4-95	W.O. 10082	
CHECKED BY: ERA	DATE 4-95	SHEET NO. E5	REV 4
APPROVED BY	DATE		

ISSUED FOR FABRICATION