


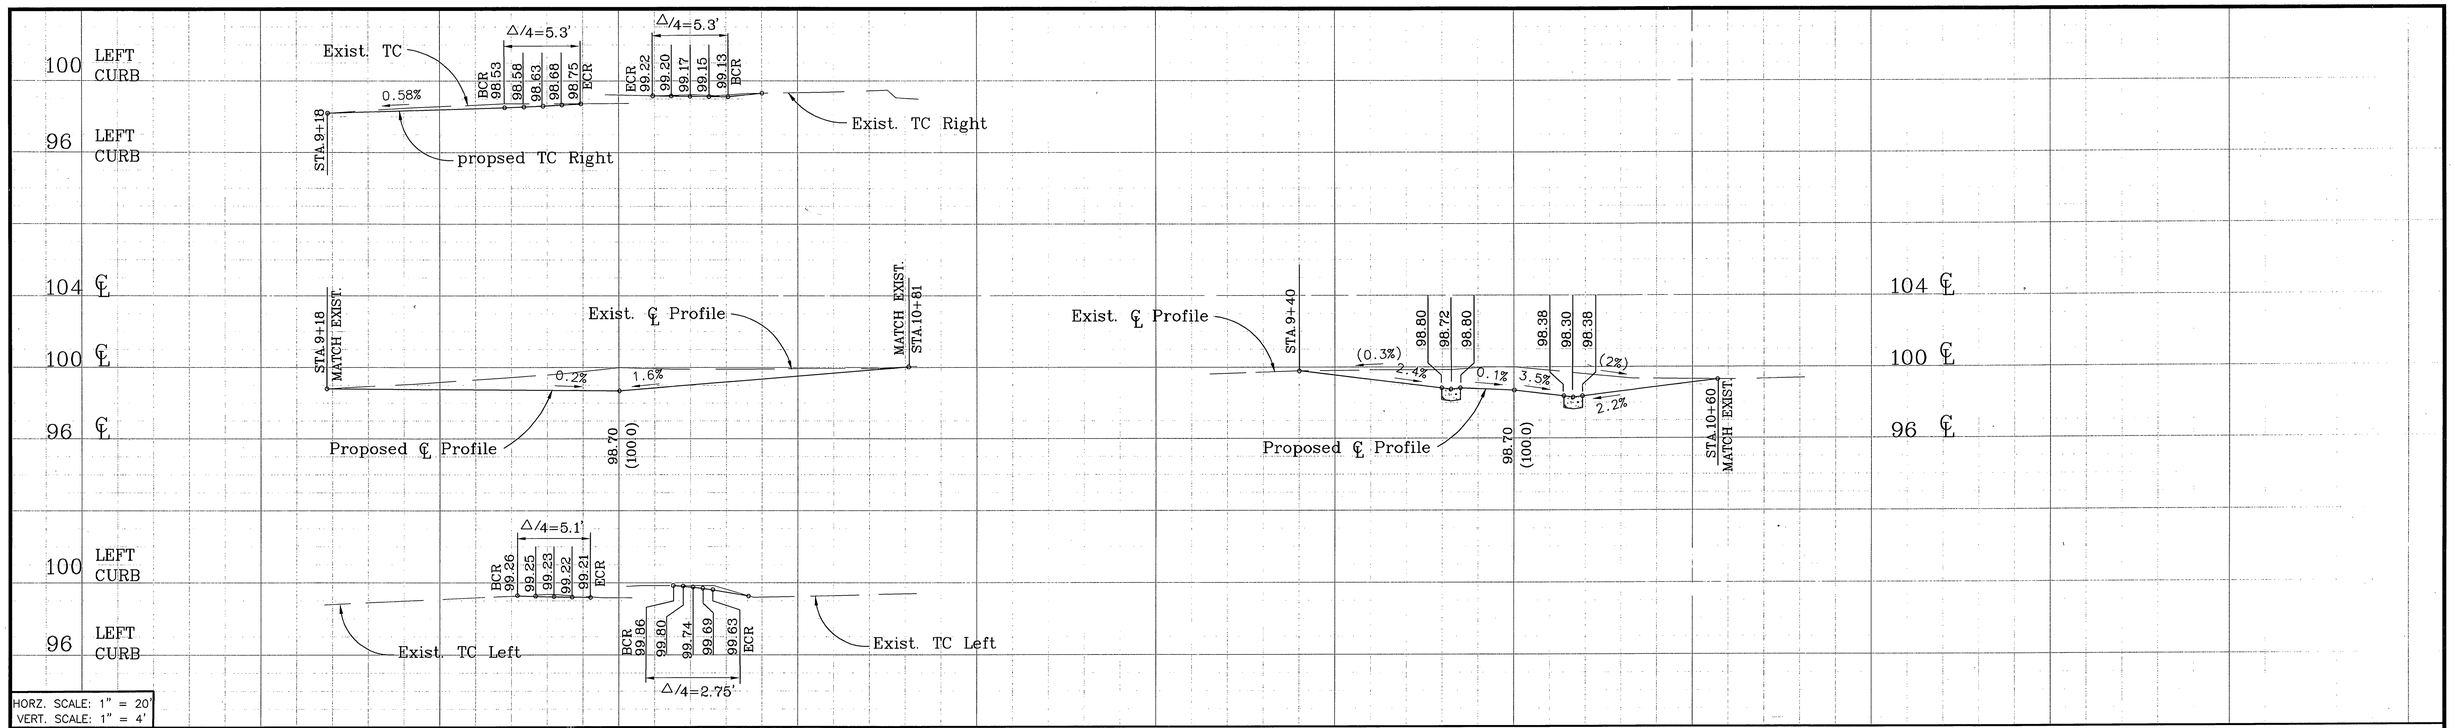


CONSTRUCTION NOTES:

⬢ NUMBERS ABOVE 100 IN A HEXAGON ON THE PLAN REFER TO THE RESPECTIVE STANDARD DRAWING AND SHALL BE CONSTRUCTED ACCORDINGLY. UNLESS MODIFICATIONS ARE NOTED ON THE PLAN OR COVER SHEET. ANY NUMBER SHOWN BELOW THE STANDARD DRAWING NUMBER INDICATES THE SPECIFIC ALTERNATE TO BE CONSTRUCTED.

(1) REMOVE EXISTING A.C. PAVEMENT AND BASE/SUBBASE. CONSTRUCT 6" FULL-DEPTH DGAC AS DIRECTED BY THE ENGINEER.

AS-BUILT PLAN BY KORMX, INC. AS PER NOTES

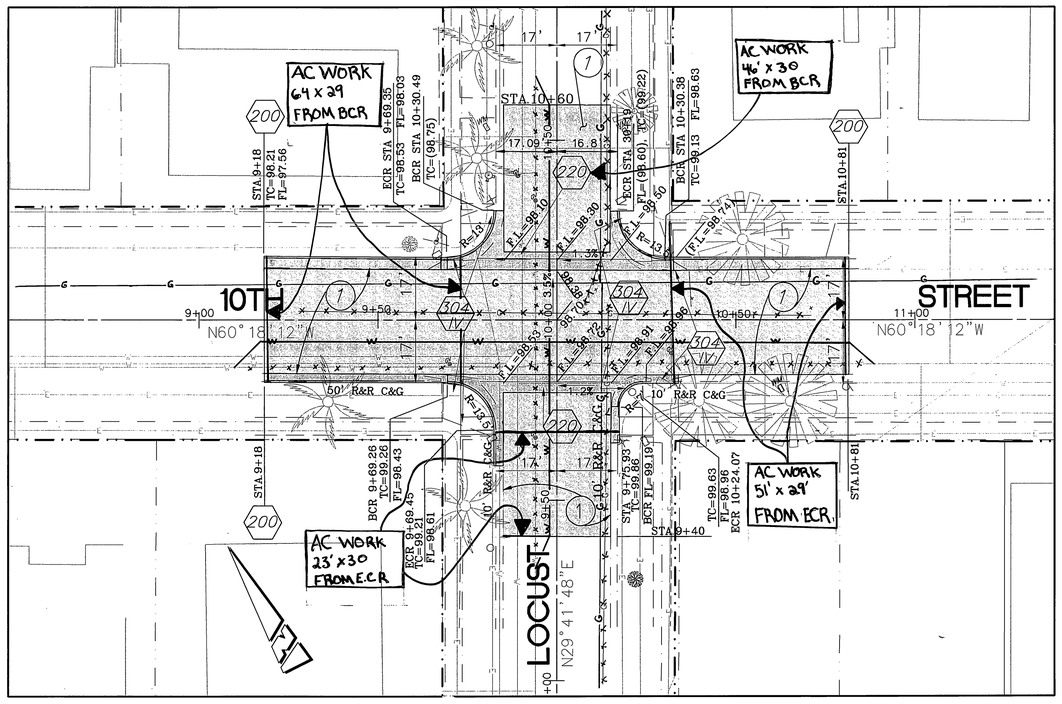Underground Service Alert
CALL BEFORE YOU DIG
Call: TOLL FREE
1-800 227-2600
TWO WORKING DAYS BEFORE YOU DIG

CITY OF RIVERSIDE

ENGINEER IN RESPONSIBLE CHARGE
Ibrahim Massoud
IBRAHIM A. MASSOUD
R.C.E. No. 64224 expires 8/30/09
DATE 12-7-09

REGISTERED PROFESSIONAL ENGINEER IBRAHIM A. MASSOUD No. 64224 Exp. 6-30-2009 CIVIL STATE OF CALIFORNIA

| MARK | REVISIONS | APPR. | DATE |
|---|---|---|---|

DESIGNED BY AE DRAWN BY AE CHECKED BY AM

| APPROVED BY | BY | DATE |
|---|---|---|
| ENGINEERING MANAGER | DH | 12/4/09 |
| CONSTRUCTION ADMIN. | AS | 12/4/09 |
| SURVEYOR | CS | 12/4/09 |
| STREET SERVICES | JEF | 5-4-10 |

CITY OF RIVERSIDE, CALIFORNIA
PUBLIC WORKS DEPARTMENT
APPROVED BY
CITY ENGINEER
DATE 12/4/09

10TH ST AND LOCUST ST INTERSECTION IMPROVEMENTS

HORIZ. SCALE: 1"=20' VERT. SCALE: 1"=4'

R-4148
SHEET 1 OF 1
FILE NO.

AS-BUILT 1-22-11