FIELD BOOKS:
1911 ACT № 6/40

BENCH MARKS:
S. ℄ L IN EASTERLY CURB, MADISON ST 3' SOUTHERLY OF ℄ FERN. ELEV. 880.05
"X" ON FIRE HYDRANT SOUTH EAST CORNER OF FERN & CARY ELEV. 885.84
"X" ON FIRE HYDRANT SOUTH EAST CORNER OF FERN & GRACE ELEV. 881.01

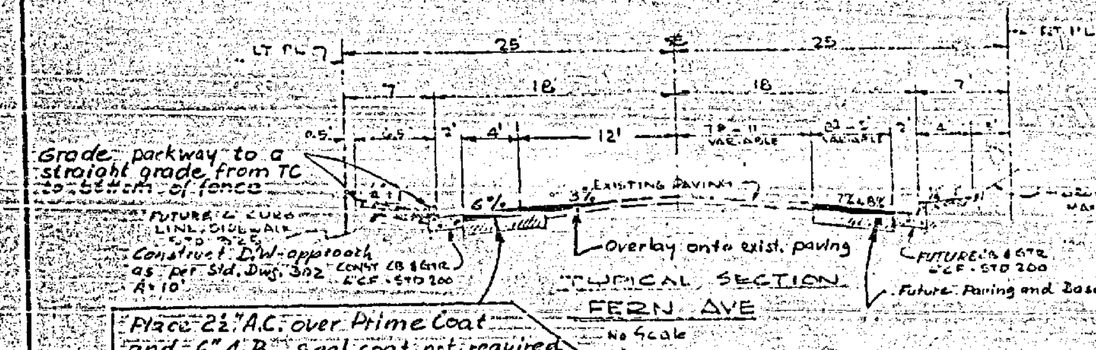

TYPICAL SECTION
FERN AVE
No Scale

Place 2½" A.C. over Prime Coat and 6" A.B. Seal coat not required

CURB RETURN DATA

NO	R	Δ	T	L
1	27	85°55'00"	41.60	42.40
2	27	90°01'00"	27.00	42.42
3	27	89°57'00"	26.98	42.39
4	27	90°00'00"	27.00	42.41
5	27	85°30'00"	25.02	40.28
6	27	90°03'00"	27.02	42.43

GENERAL NOTES

1. IT SHALL BE RESPONSIBILITY OF THE CONTRACTOR TO CLEAR THE RIGHT OF WAY IN ACCORDANCE WITH THE PROVISIONS OF LAW AS IT AFFECTS EACH UTILITY INCLUDING IRRIGATION LINES AND APPURTENANCES AND AT NO EXTRA COST TO THE CITY.
2. CONSTRUCTION SHALL BE IN ACCORDANCE WITH THE CITY OF RIVERSIDE DEPT OF PUBLIC WORKS SPECIFICATIONS NO 461 AND STANDARD DRAWINGS.
3. TRIM EDGE OF EXISTING PAVING WHERE NEW PAVING JOINS EXISTING PAVEMENT TO CLEAN STRAIGHT LINE. CONSTRUCT MATCHED PAVING AS SHOWN, AND OVERLAY EXISTING PAVING AS DIRECTED IN FIELD TO PRODUCE SMOOTH CROWN SECTION.
5. RELOCATE EXISTING SIGNS AND MAIL BOXES AS REQ'D. AS DIRECTED IN FIELD. REMOVE AND DISPOSE OF ANY TOPO WITHIN GRADING AREA THAT INTERFERES WITH CONST.

Note Approval of this Sheet is from Sta. 10+09 to 10+56.7 Lt. only.

REVISIONS		
MARK	DATE	DESCRIPTION
1	9-16-64	Adopted from Plan R-431 to show Improvements for House 7650 Fern St. in Connection for a Building Permit.

CITY OF RIVERSIDE, CALIFORNIA
DEPARTMENT OF PUBLIC WORKS

FERN AVE. - CARY ST. IMPROVEMENT DISTRICT

FERN AVE.
GRACE ST. to MADISON ST.

DESIGNED BY: d.b.
DRAWN BY: d.b. AEI
CHECKED BY: [signature] RE 9876
RECOMMENDED BY: A. R. Theal, ASSISTANT CITY ENGINEER
APPROVED BY: [signature] DIRECTOR OF PUBLIC WORKS
DATE 9-24-64

R-431-C
SHEET 1 OF 1

Dwg No. 60-220 A