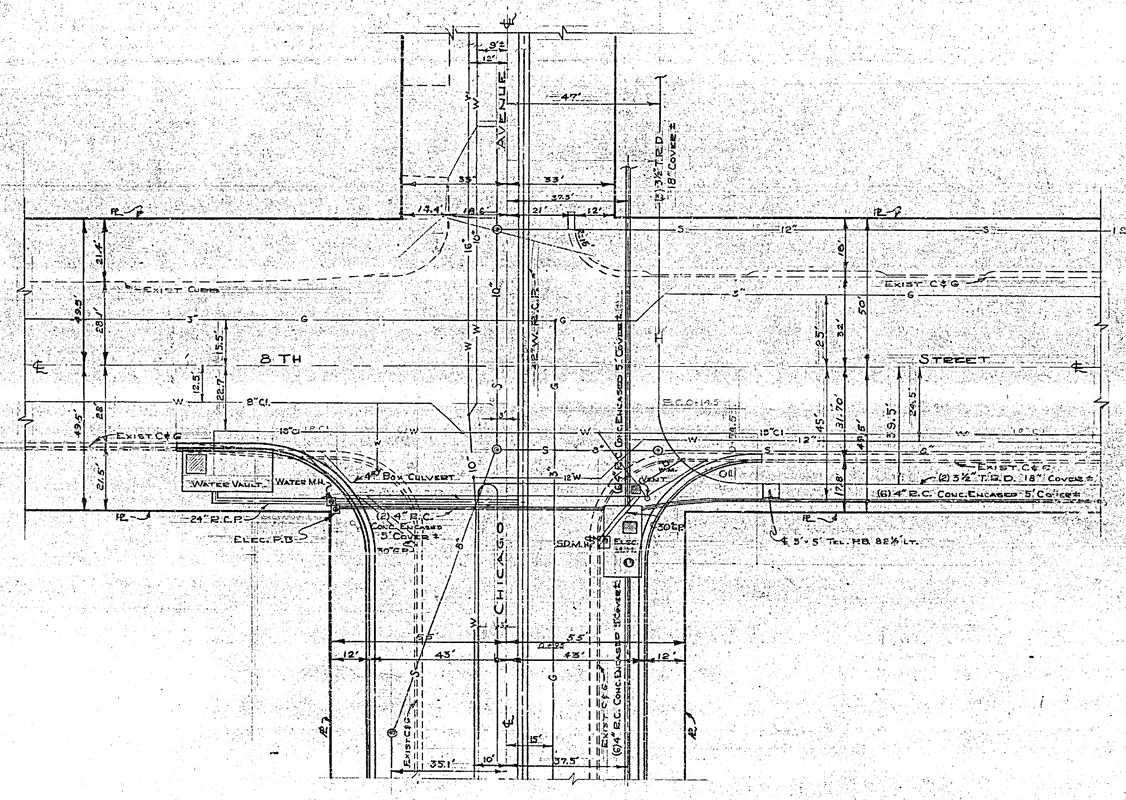

SCALE 1" = 20'

REVISIONS		
MARK	DATE	DESCRIPTION

CITY OF RIVERSIDE, CALIFORNIA
DEPARTMENT OF PUBLIC WORKS

INTERSECTION
8TH ST. — CHICAGO AVE.
UNDERGROUND LOCATIONS
(NOT PART OF CHICAGO AVE. CONT.)

DESIGNED BY
DRAWN BY A.F.W.
CHECKED BY
RECOMMENDED BY
ASSISTANT CITY ENGINEER
APPROVED BY
DIRECTOR OF PUBLIC WORKS
DATE
R 536 A
SHEET OF