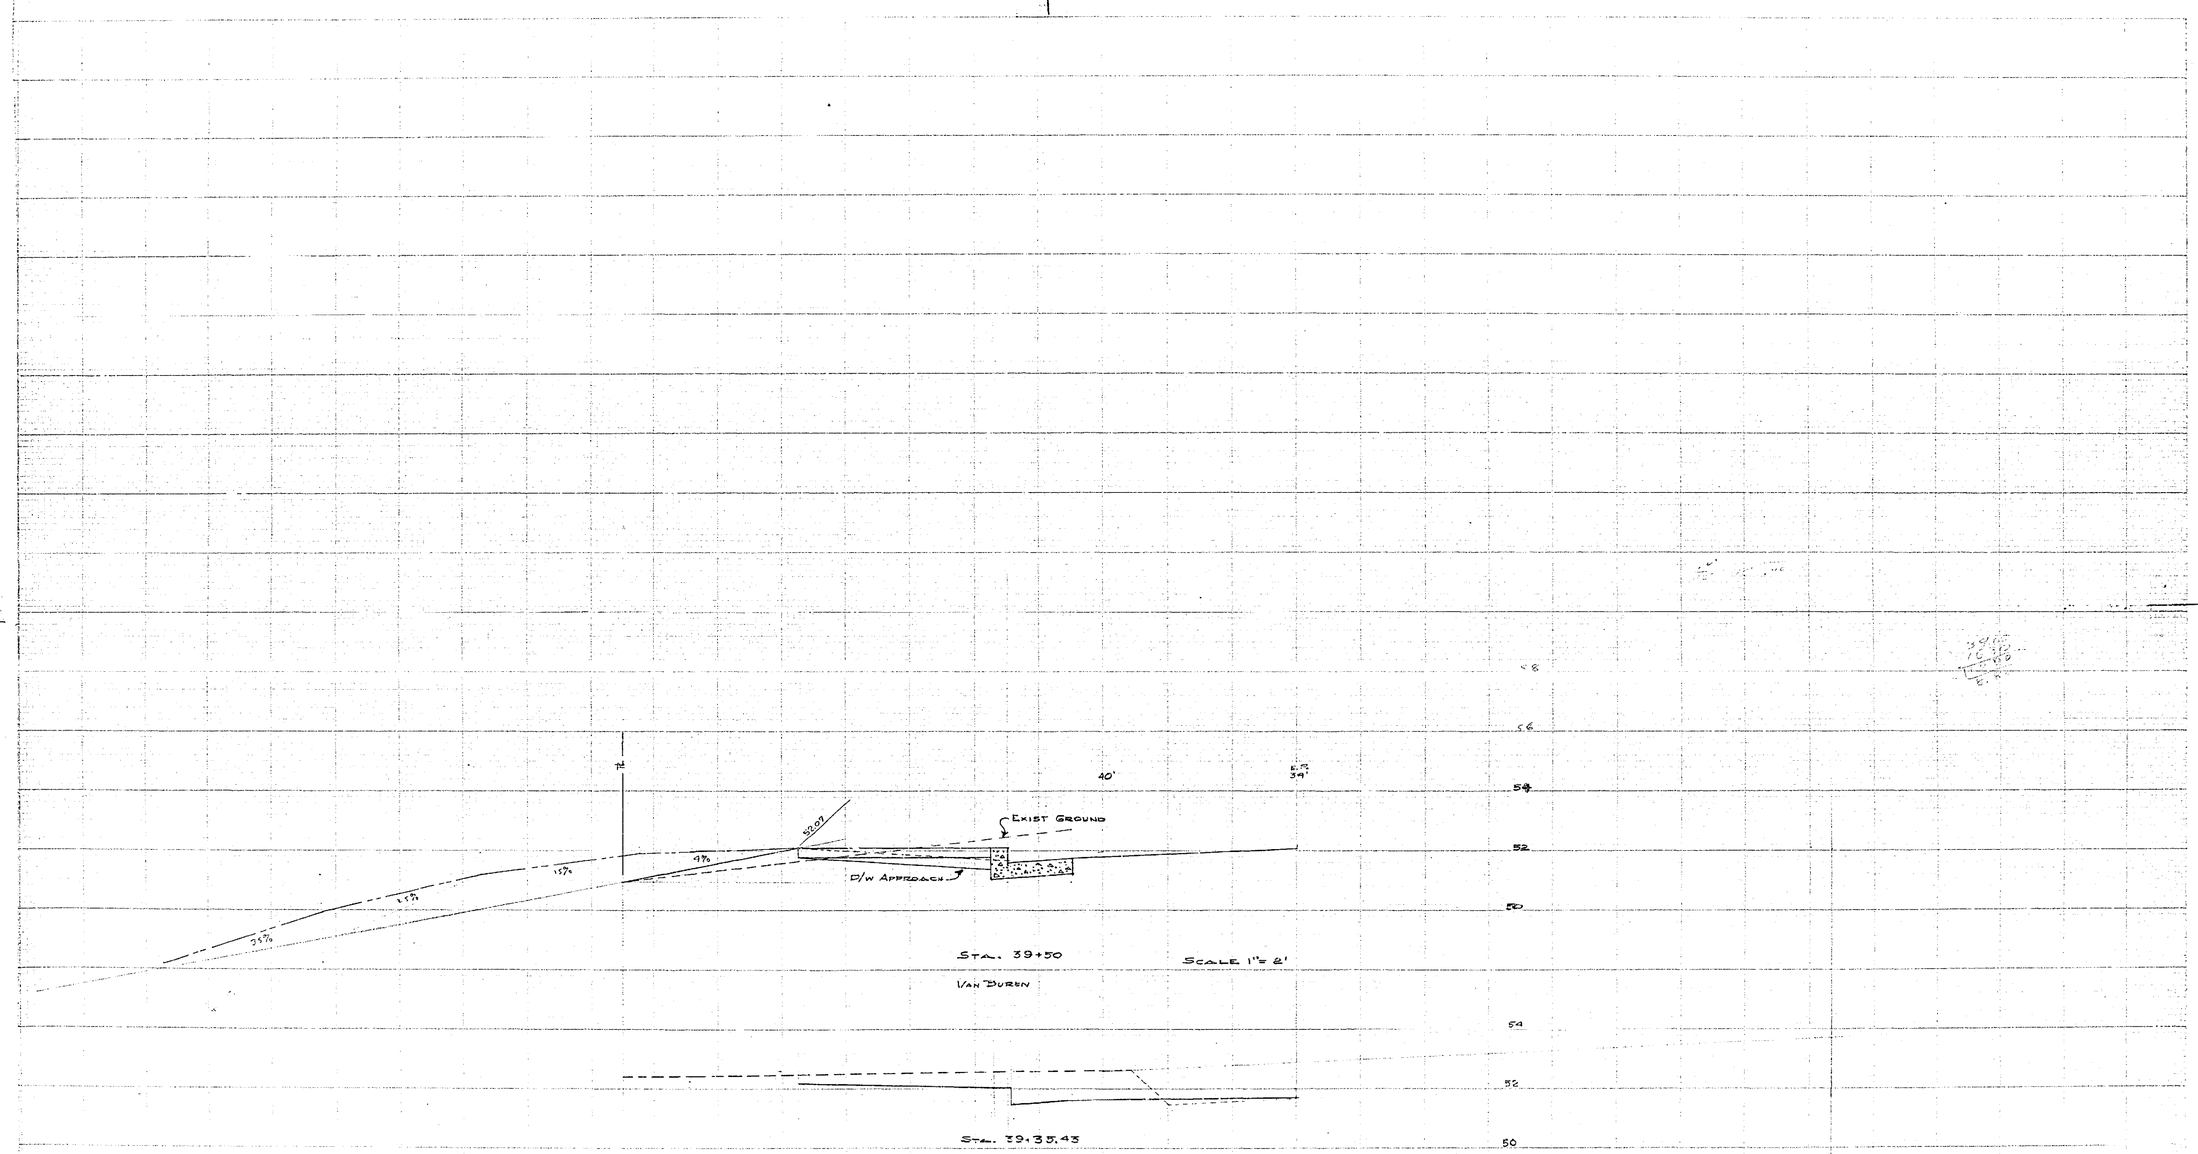

EXIST GROUND
D/W APPROACH
40'
34'
52.07
4%
15%
25%
35%
STA. 39+50
VAN BUREN
SCALE 1"= 2'
STA. 39+35.43
58
56
54
52
50
54
52
50

R-629 A

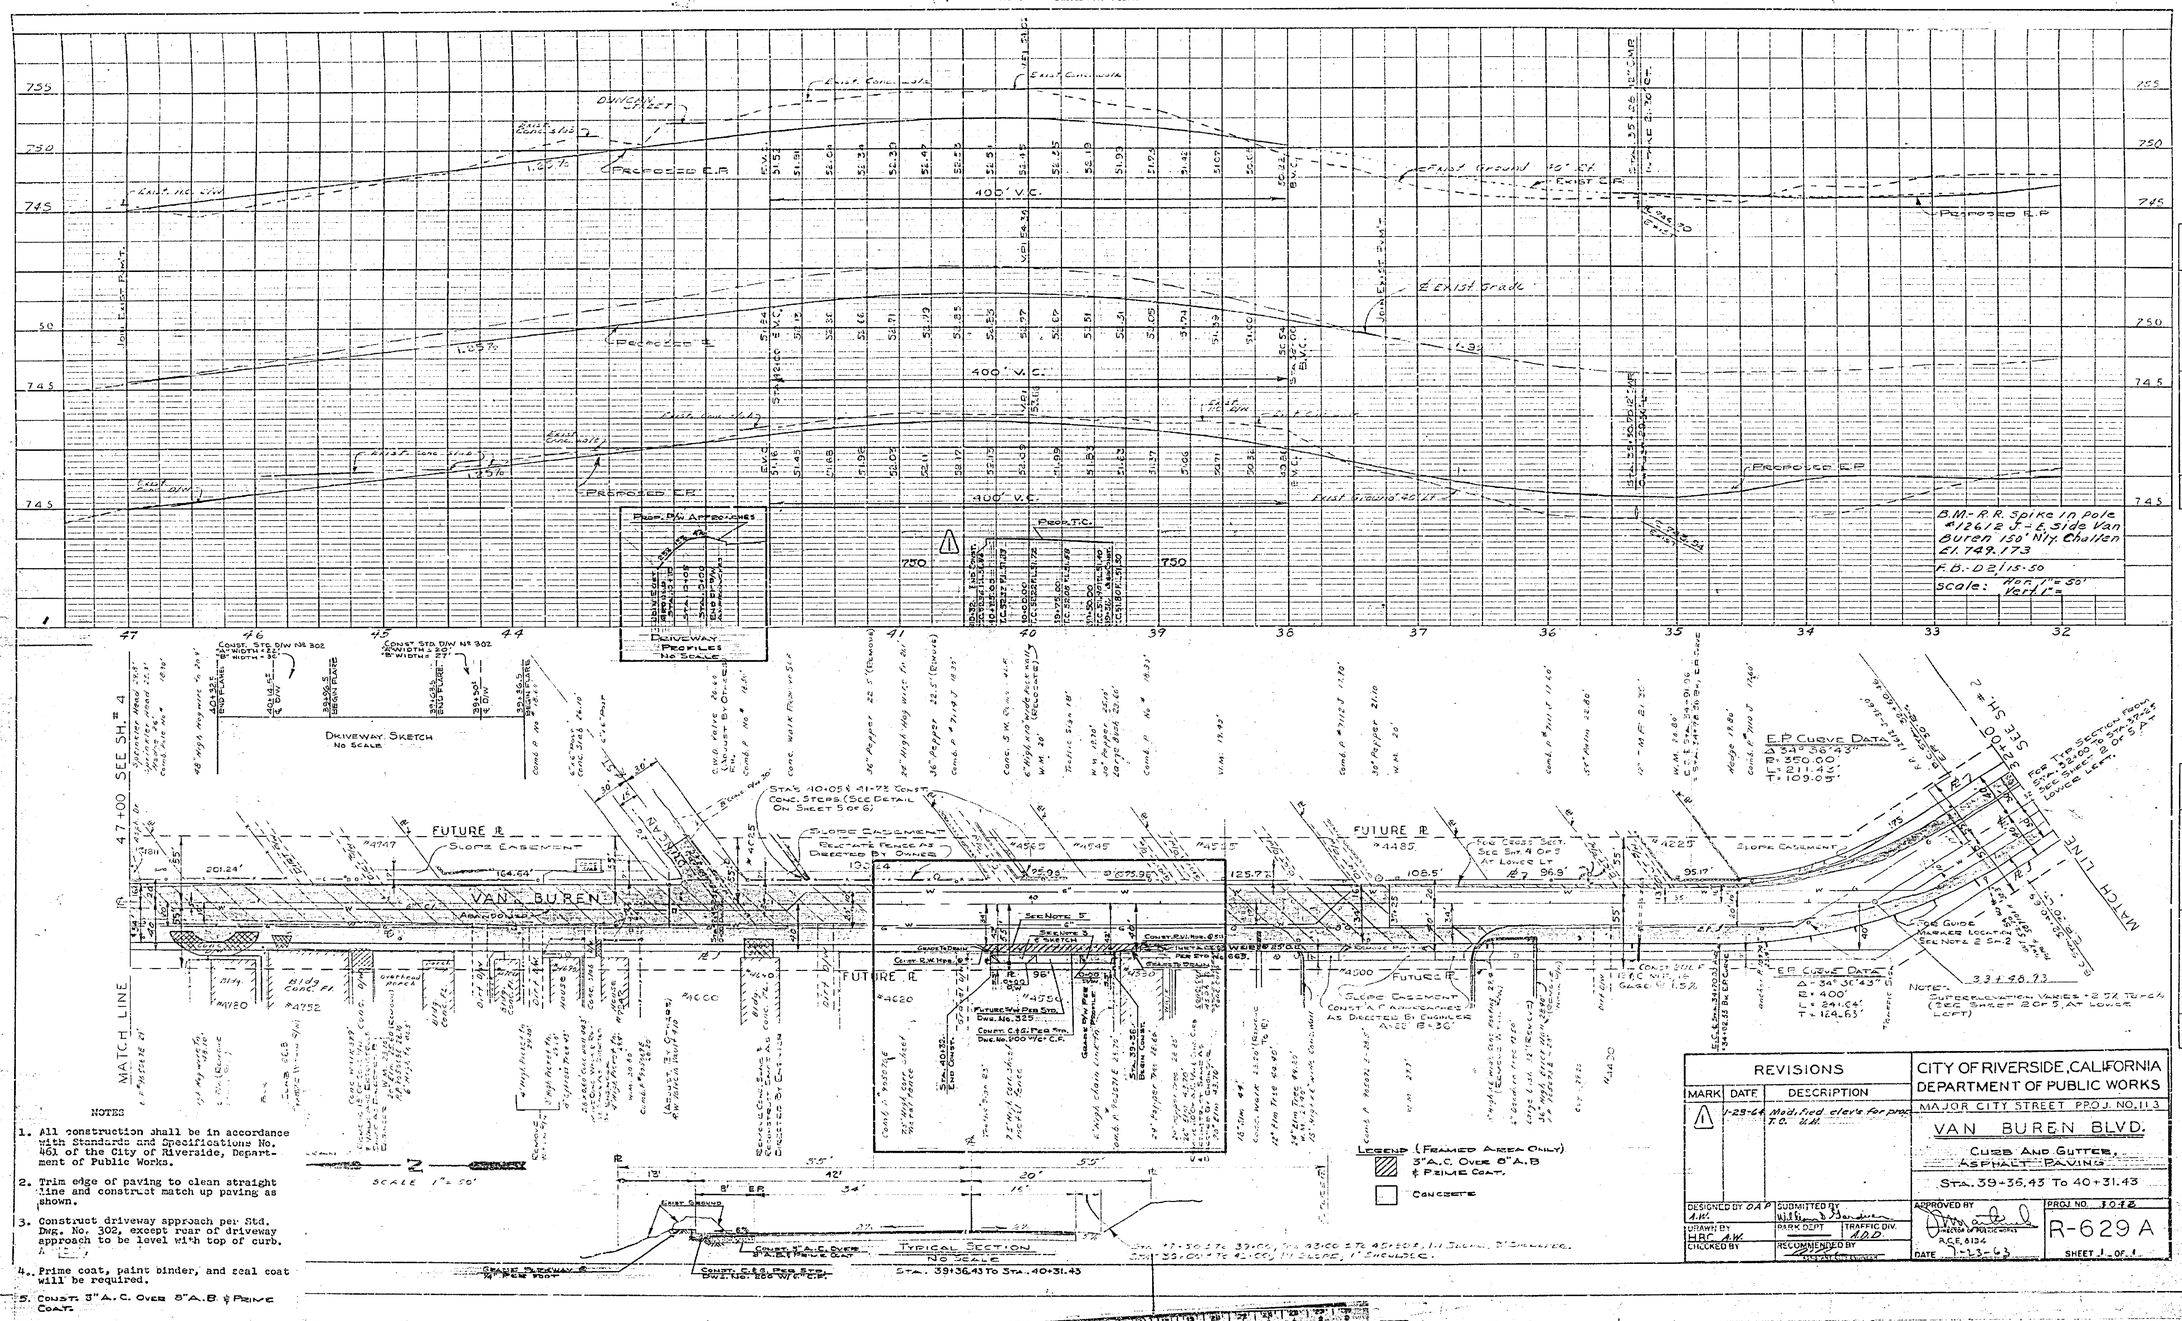

NOTES

1. All construction shall be in accordance with Standards and Specifications No. 461 of the City of Riverside, Department of Public Works.
2. Trim edge of paving to clean straight line and construct match up paving as shown.
3. Construct driveway approach per Std. Dwg. No. 302, except rear of driveway approach to be level with top of curb.
4. Prime coat, paint binder, and seal coat will be required.
5. Const. 3" A.C. Over 8" A.B. & Prime Coat.