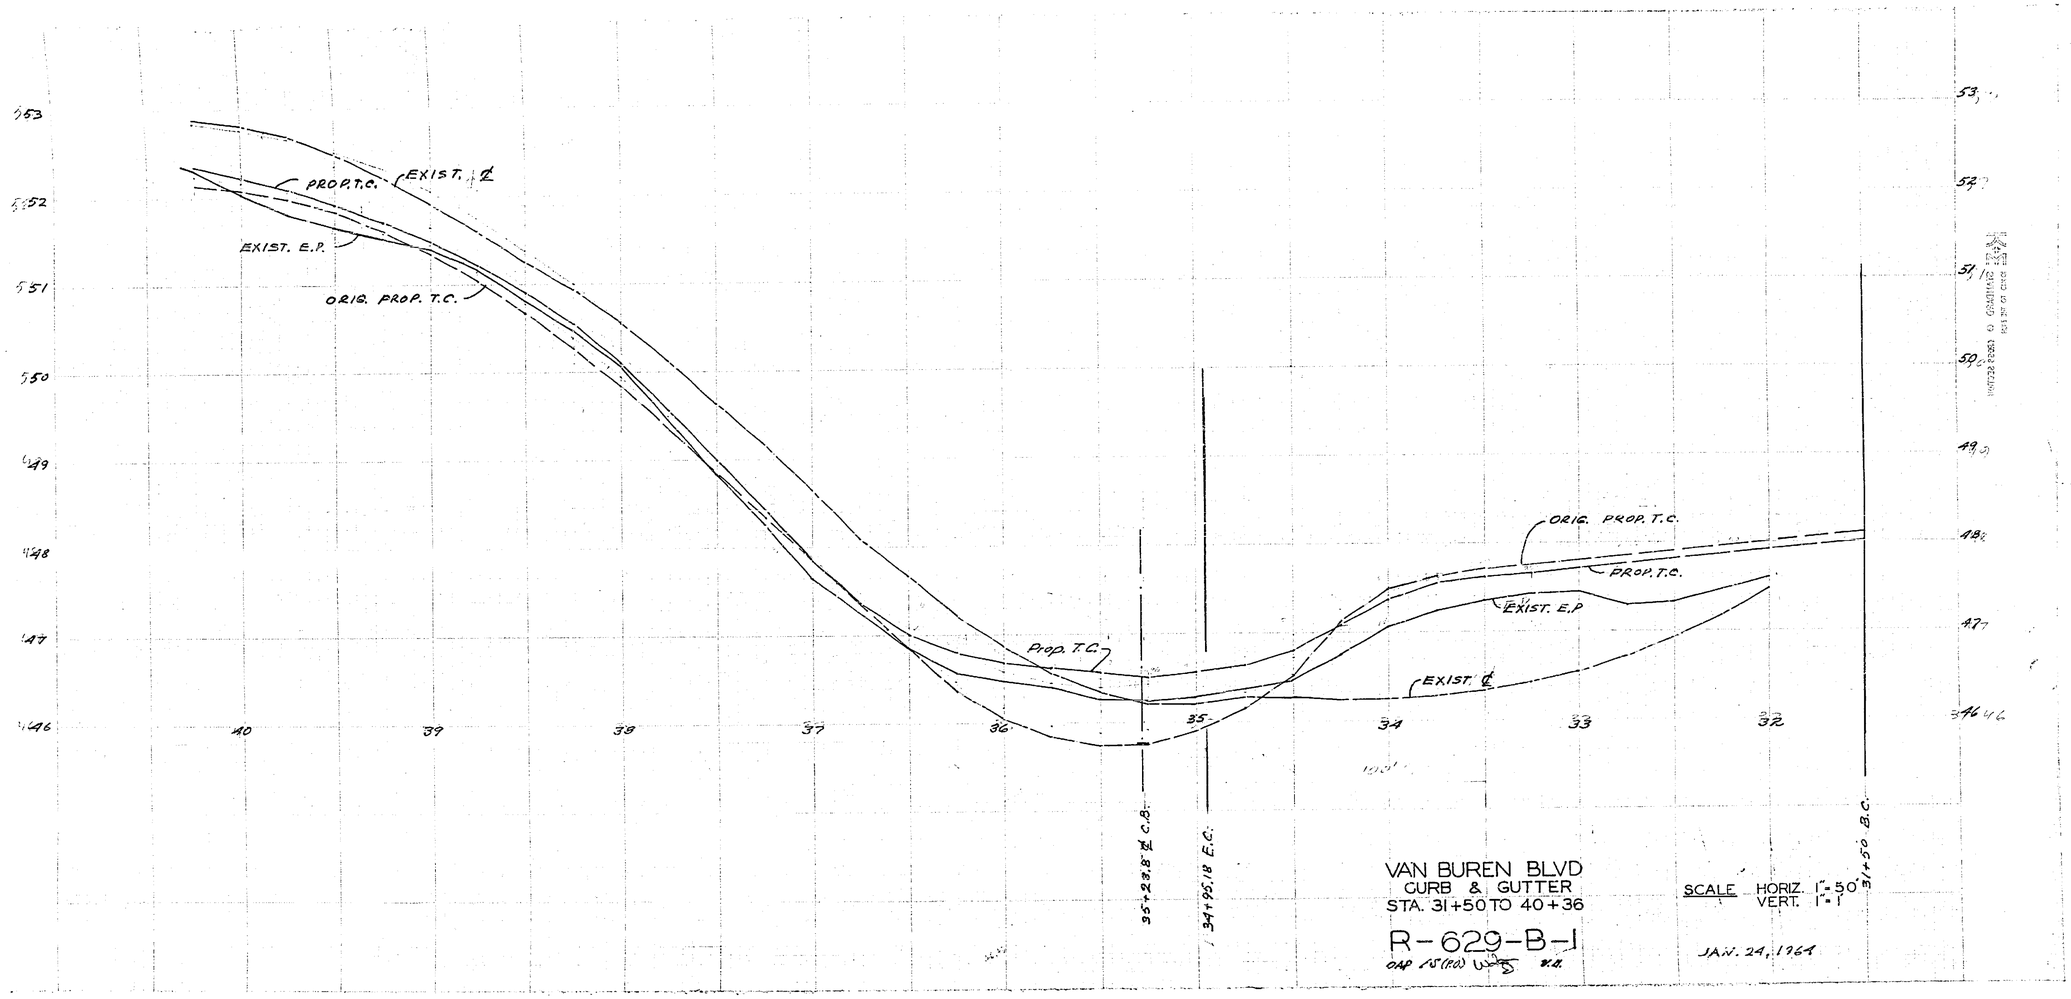
PROP. T.C.
EXIST. ℄
EXIST. E.P.
ORIG. PROP. T.C.
Prop. T.C.
ORIG. PROP. T.C.
PROP. T.C.
EXIST. E.P
EXIST. ℄
35+28.8 ℄ C.B.
34+95.18 E.C.
31+50 B.C.
VAN BUREN BLVD
CURB & GUTTER
STA. 31+50 TO 40+36
R-629-B-1
SCALE HORIZ. 1"=50'
VERT. 1"=1'
JAN. 24, 1964